


Map No. 7 Sec. 17 Twp. 22 R. 10

Well No. 5-Browning Farm
Rhodes Ed abell Company

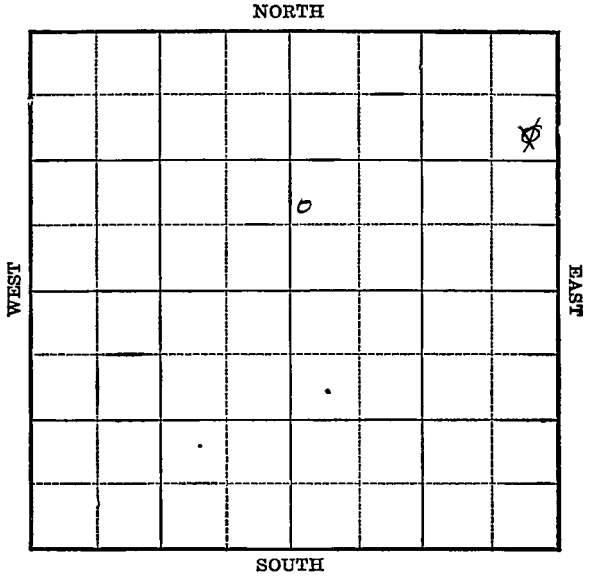

Location _____

Rig Up _____

Drilling Remarks:

Drilling Remarks:

RECORD

PRODUCTION

Cased _____ in. _____ ft.

1st 24 hrs. Nat. _____

Sand _____

1st 24 hrs. after shot _____

Gas _____

Gas _____ cu. ft.

Oil _____

Dry Hole _____

Total Depth _____

Abandoned _____

Map No. KANSAS 21 Sec. 17 Twp. 22 R. 10

Well No. 5 Brawning
R. Rhodes & Abell Company

Contractor

FIRST REPORT

SECTION PLAT

990 Ft. from N. Line

_____ Ft. from S. Line

330 Ft. from E. Line

_____ Ft. from W. Line

			6

Location _____

Rig up _____

Drilling and Remarks:

Timber

RECORD

Cased _____ in., _____ ft.

Sand _____

Gas _____

Oil _____

Total Depth _____

PRODUCTION

1st 24 hrs. Nat. _____

1st 24 hrs. after shot _____

Gas _____ Cu. Ft.

Dry Hole _____

Abandoned _____

Date

FEB 21 1924

M. A. BENEAR

192

Scout

21 Map No. **KANSAS** Sec. 17 Twp. 22 R. 10

Well No. 5 Brauning
Rhodes & Abel Company

Contractor

COMPLETED SECTION PLAT

_____ Ft. from N. Line

740 Ft. from S. Line

_____ Ft. from E. Line

200 Ft. from W. Line

Location _____

Rig up _____

Drilling and Remarks:

swell 2305-68
Play back 2350
60/20

RECORD

Cased _____ in., _____ ft.

Sand _____

Gas _____

Oil _____

Total Depth _____

PRODUCTION

1st 24 hrs. Nat. _____

1st 24 hrs. after shot _____

Gas _____ Cu. Ft.

Dry Hole _____

Abandoned _____

Date

JUN 18 1924

M. A. BENEAR

192

Scout