

Well No. 10 Browning Farm
Theta Oil Co. Company

WEST

EAST

SOUTH

0

[illegible]

Cased _____ in. _____ ft.
 Sand _____
 Gas _____
 Oil _____
 Total Depth _____

[illegible]

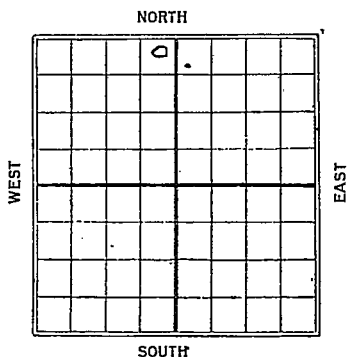
1st 24 hrs. Nat. _____
1st 24 hrs. after shot _____
Gas _____ cu. ft _____
Dry Hole _____
Abandoned _____

Map No. Kansas Sec. 17 Twp. 22 R. 10Well No. 10 Browning FarmTheta Oil Co Company330 Ft. from N. Line

_____ Ft. from S. Line

330 Ft. from E. Line

_____ Ft. from W. Line

Date
1925

REPORT

5/1 Spudding

6/5 Sly 1475

6/12 2305-2315-Pay 2315-T.D. 400' in
oil hole will shoot

6/18 \$ 2305-05
Dry sand 2305-15
Pay 2315-20 40 gals
60 Bbls

Map No. 21111111 Sec. 17 Twp. 22 R. 10
 Well No. 10 Browning
Shelton Oil Co. Company

Contractor

SECTION PLAT

330 Ft. from N. Line

_____ Ft. from S. Line

330 Ft. from E. Line

_____ Ft. from W. Line

FIRST REPORTS

Location _____

Rig up _____

Drilling and Remarks:

Spudding

RECORD

Cased _____ in., _____ ft.

Sand _____

Gas _____

Oil _____

Total Depth _____

PRODUCTION

1st 24 hrs. Nat. _____

1st 24 hrs. after shot _____

Gas _____ Cu. Ft.

Dry Hole _____

Abandoned _____

Date
 MAY 1 1925

CHAS. L. SHERWOOD

192 _____ Scout

Map No. 21 1/2 Sec. 17 Twp. 22 R. 10
 Well No. 10 Blowing
Theta Oil Co. Company

Contractor

COMPLETED

SECTION PLAT

330

Ft. from N. Line

Ft. from S. Line

330

Ft. from E. Line

Ft. from W. Line

Location

Rig up

Drilling and Remarks:

Tap Oil at 2300-05Dry at 2305-2315Pay 2315-232040y 60 b/s

RECORD

Cased _____ in., _____ ft.

Sand _____

Gas _____

Oil _____

Total Depth 2320

PRODUCTION

1st 24 hrs. Nat. _____

1st 24 hrs. after shot _____

Gas _____ Cu. Ft.

Dry Hole _____

Abandoned _____

Date

JUN 18 1925

192

CHAS. L. SHERWOOD

Scout