


Well No. 18 - Browning Farm
Theta oil co. Company

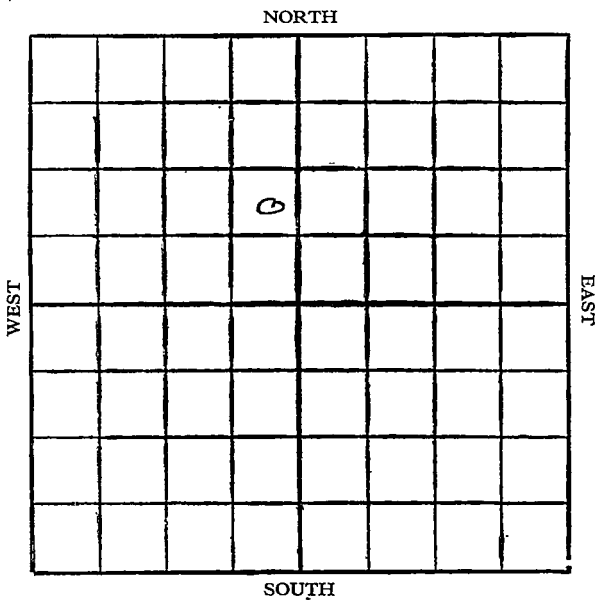

Drilling Remarks

Drilling Remarks

PRODUCTION

1st 24 hrs. Nat.

1st 24 hrs. after shot.....

Gas..... cu. ft.

Dry Hole.....

Abandoned


Map No. _____ Sec. 17 Twp. 22 R. 10Well No. 18-Browning Farm
Theta Oil Co Company

_____ Ft. from N. Line

990 Ft. from S. Line330 Ft. from E. Line

_____ Ft. from W. Line

NORTH

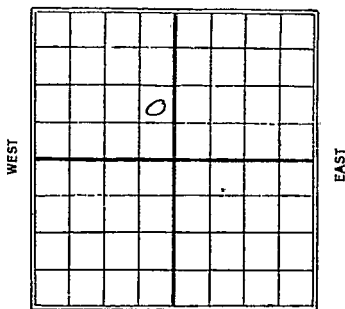

SOUTH

1927

Date

REPORT

2/3 Rigging up2/10 Spudding2/17 Drill 7002/24 " 10003/2 " 13903/9 " 16003/16 " 18203/24 sand 2318-2348P.B. to 2343'120/125 bbls

21 KANSAS

Sherwood

Map No. _____ Sec. 17 Twp. 22 R. 10

Well No. 18 Browning

Hetz & Co.

Company

Contractor

FIRST REPORTS

SECTION PLAT

Ft. from N. Line

990

Ft. from S. Line

330

Ft. from E. Line

Ft. from W. Line

	o		

Location _____

Rig up _____

Drilling and Remarks:

Rigging up.

RECORD

Cased _____ in., _____ ft.

Sand _____

Gas _____

Oil _____

Total Depth _____

PRODUCTION

1st 24 hrs. Nat. _____

1st 24 hrs. after shot _____

Gas _____ Cu. Ft.

Dry Hole _____

Abandoned _____

Date

DEC 3 1927

192

CHAS. L. SHERWOOD

Scout

Sherwood

21 KANSAS

Map No. _____ Sec. 17 Twp. 22 R. 10

Well No. 18 Browning

Shetz oil Co Company

Contractor

COMPLETED

SECTION PLAT

_____ Ft. from N. Line

990 Ft. from S. Line

220 Ft. from E. Line

_____ Ft. from W. Line

	o		

Location _____

Rig up _____

Drilling and Remarks:

P.B. to 2343'

1209 125 lbs

RECORD

Cased _____ in. _____ ft.

Sand 2318-2348

Gas _____

Oil _____

Total Depth 2348

PRODUCTION

1st 24 hrs. Nat. _____

1st 24 hrs. after shot _____

Gas _____ Cu. Ft.

Dry Hole _____

Abandoned _____

Date

MAR 24 1927

CHAS. L. SHERWOOD

192 Scout