


Map No. KANSAS Sec. 17 Twp. 22 R. 10E

Well No. 29 - Browning Farm

Shute Oil Company

NORTH

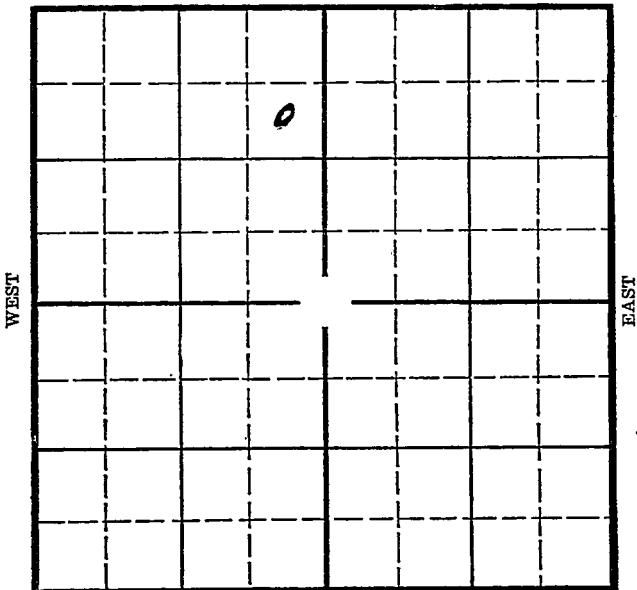

SOUTH

3

Location _____
Drilling Remarks _____

Rig Up _____
Drilling Remarks _____

RECORD

PRODUCTION

Cased _____ in. _____ ft.
Sand _____
Gas _____
Oil _____
Total Depth _____


1st 24 hrs. Nat. _____
1st 24 hrs. after shot _____
Gas _____ cu. ft. _____
Dry Hole _____
Abandoned _____

Greenwood

Map No. KANSAS Sec. 17 Twp. 22 R. 10E

Well No. 20 - Browning Farm
Theta oil Company

990 Ft. from N. Line
 Ft. from S. Line
330 Ft. from E. Line
 Ft. from W. Line

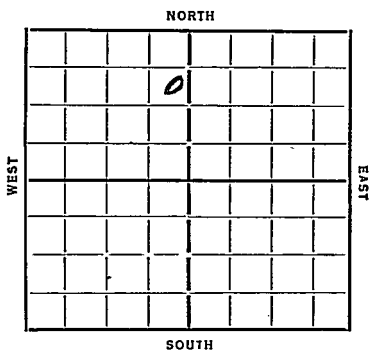

Date 1935 REPORT

6/19 Machine
6/28
7/3 Rigs
7/11
7/18 15" 340
8/8 ddy 2100
8/15 Lat sand 2264-2302
8/21 200' pit 10 hrs.
 sand 2264
 T 7 2302
 P B 2299
 80 ft 50 lbs.

COMPLETED

Map No. 21 Sec. 17 Twp. 22 R. 10 E

Well No. 20-Browning
T beta oil Company

Contractor

FIRST REPORTS

SECTION PLAT

990 Ft. from N. Line
..... Ft. from S. Line
330 Ft. from E. Line
..... Ft. from W. Line

	0		

Location.....
Rig up.....
Drilling and Remarks:

Machine

RECORD

Cased..... in., ft.
Sand.....
Gas.....
Oil.....
Total Depth.....

PRODUCTION

1st 24 hrs. Nat.....
1st 24 hrs. after shot.....
Gas..... Cu. Ft.
Dry Hole.....
Abandoned.....

Date
6-19-35 192.....

ORVAL NANNBACHRECK

Scout

Map No. 21 Sec. 17 Twp. 22 R. 10 E

Well No. 20 - Browning

T Keta oil Company

Contractor

~~CONFIDENTIAL~~

SECTION PLAT

990 Ft. from N. Line

..... Ft. from S. Line

330 Ft. from E. Line

..... Ft. from W. Line

	0		

Location

Rig up

Drilling and Remarks:

PB 2299
809ft
50 bbls

RECORD

Cased..... in., ft.

Sand 2264

Gas

Oil

Total Depth 2302

PRODUCTION

1st 24 hrs. Nat.....

1st 24 hrs. after shot.....

Gas..... Cu. Ft.

Dry Hole.....

Abandoned.....

Date 8-21-35 192.....

~~CONFIDENTIAL~~

Scout