


Greenwood

Map No. *KS* Sec. *17* Twp. *22* R. *11E*^X

Well No. *1 - Peck* Farm _____
O'Neal Lumber Co. Company

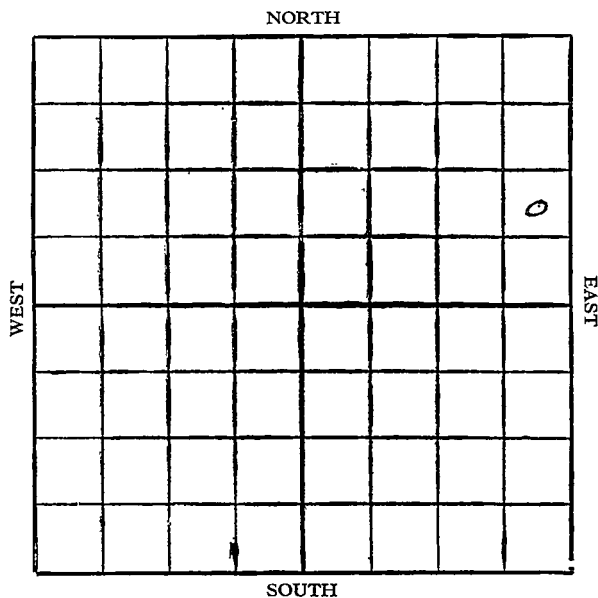

Location

Drilling Remarks

.....

.....

RECORD

Cased in. ft.

Sand

Gas

Oil

Total Depth

Rig Up

Drilling Remarks

.....

.....

PRODUCTION

1st 24 hrs. Nat.


1st 24 hrs. after shot

Gas cu. ft.

Dry Hole

Abandoned

Form 32 S.C.O.P.Co.—1M Bks.—2-25—18417 *Greenwood*
 21 KANSAS
 Map No. _____ Sec. *17* Twp. *22* R. *11*^E
 Well No. *1 Peet* Farm _____
O'Neal & Tidal Oil Co Company

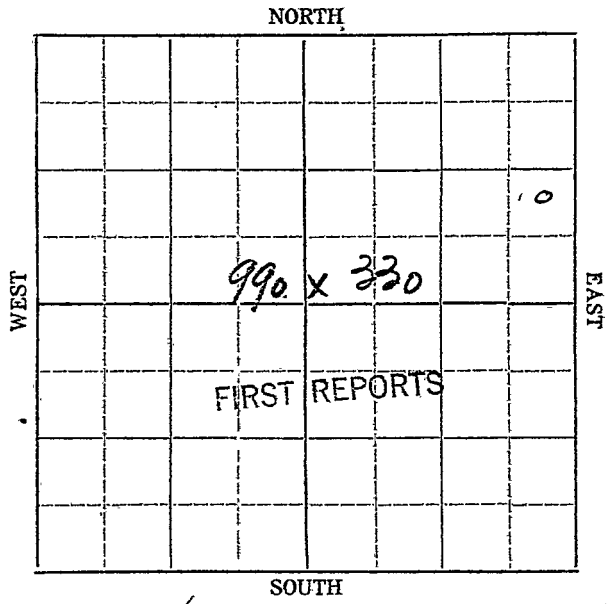

Location _____
 Rig up _____
 Drilling and Remarks: _____

RECORD

Cased _____ in., _____ ft.
 Sand _____
 Gas _____
 Oil _____
 Total Depth _____

PRODUCTION

1st 24 hrs. Nat. _____
 1st 24 hrs. after shot _____
 Gas _____ Cu. Ft.
 Dry Hole _____
 Abandoned _____

Date JAN 12 1927 **CHAS. L. SHERWOOD** Scout
 192 _____

Sherwood

21 KANSAS
Map No. _____ Sec. 17 Twp. 22 R. 11

Well No. 1
Reed
Reed & Reed Company

Contractor _____

COMPLETED

SECTION PLAT

_____ Ft. from N. Line
990 Ft. from S. Line
330 Ft. from E. Line
_____ Ft. from W. Line

			o

ABANDONED

Location _____
Rig up _____
Drilling and Remarks:

RECORD

Cased _____ in., _____ ft.
Sand _____
Gas _____
Oil _____
Total Depth _____

PRODUCTION

1st 24 hrs. Nat. _____
1st 24 hrs. after shot _____
Gas _____ Cu. Ft.
Dry Hole *Yes*
Abandoned _____

old location

Date
FEB 10 1927
192. CHAS. L. SHERWOOD Scout