


Map No. _____ Sec. 17 Twp. 22 R. 11
 Well No. #1 - Peck Farm _____
Titus et al Company

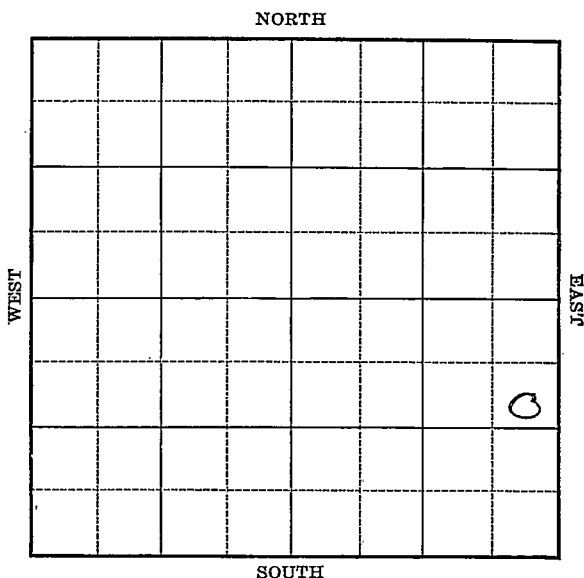

Location _____

Drilling Remarks _____

Rig Up _____

Drilling Remarks _____

RECORD

Cased _____ in. _____ ft.

Sand _____

Gas _____

Oil _____

Total Depth _____

PRODUCTION

1st 24 hrs. Nat. _____

1st 24 hrs. after shot _____

Gas _____ cu. ft.

Dry Hole _____

Abandoned _____

Map No. 17 Sec. 17 Twp. 22 R. 11


Well No. 1- Beet Farm
Titus et al Company

990 Ft. from N. Line

_____ Ft. from S. Line

330 Ft. from E. Line

_____ Ft. from W. Line

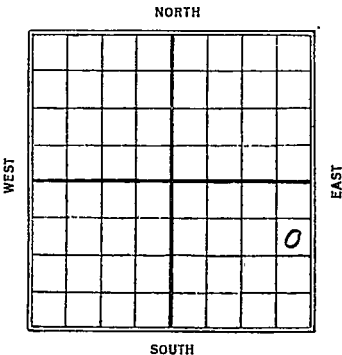

1927

Date

REPORT

10/12 Drilg 1555

10/19 no sand

Top line 2025

N.Y.A. 2110

Greenwood ✓

21 KANSAS
Map No. _____ Sec. 17 Twp. 22 R. 11Well No. 1 feet
Titus & 4V Company

Contractor

FIRST REPORTS

990 Ft. from N. Line

_____ Ft. from S. Line

830 Ft. from E. Line

_____ Ft. from W. Line

SECTION PLAT

			o

Location _____

Rig up _____

Drilling and Remarks:

dy 1555

RECORD

Cased _____ in., _____ ft.

Sand _____

Gas _____

Oil _____

Total Depth _____

PRODUCTION

1st 24 hrs. Nat. _____

1st 24 hrs. after shot _____

Gas _____ Cu. Ft.

Dry Hole _____

Abandoned _____

Date

OCT 12 1927

CHAS. L. SHERWOOD

192

Scout

*Sherwood***21 KANSAS**Map No. _____ Sect *17* Twp. *22* R. *11*Well No. *1* *Feet**Titus* *et al* _____ Company

_____ Contractor

COMPLETED**SECTION PLAT***990* Ft. from N. Line

_____ Ft. from S. Line

330 Ft. from E. Line

_____ Ft. from W. Line

ABANDONED

			0

Location _____

Rig up _____

Drilling and Remarks:

No Sand
*Top Line 2025**SHA 2110***RECORD**

Cased _____ in., _____ ft.

Sand _____

Gas _____

Oil _____

Total Depth *2110***PRODUCTION**

1st 24 hrs. Nat. _____

1st 24 hrs. after shot _____

Gas _____ Cu. Ft.

Dry Hole ☒Abandoned ☒

Date

OCT 19 1927

CHAS. L. SHERWOOD

192

Scout