


Map No. _____ Sec. 18 Twp. 22 R. 12 ✓
Well No. 1 Maxwell Farm _____
Unknown Company _____

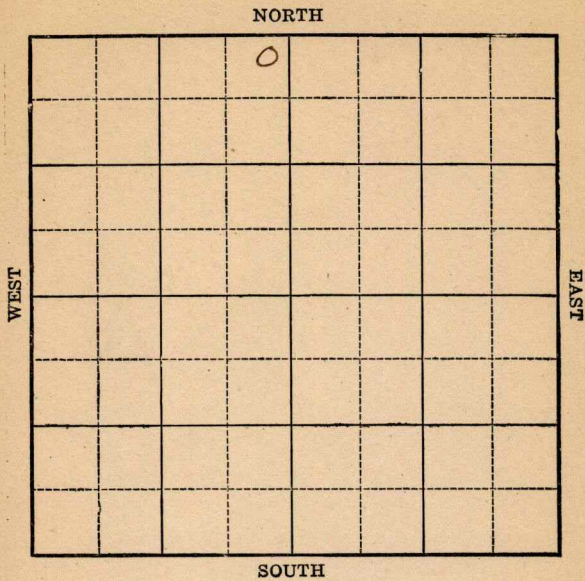

Location _____

Rig up _____

Drilling Remarks:

Drilling Remarks:

RECORD

PRODUCTION

Cased _____ in. _____ ft.

Sand _____

Gas _____

Oil _____

Total Depth _____

1st 24 hrs Nat. _____

1st 24 hrs. after shot _____

Gas _____ cu. ft.

Dry Hole _____

Abandoned _____

Map No. _____ Sec. 18 Twp. 22 R. 12


Well No. 1 Maxwell Farm
Unknown Company

200 Ft. from N. Line

_____ Ft. from S. Line

200 Ft. from E. Line

_____ Ft. from W. Line

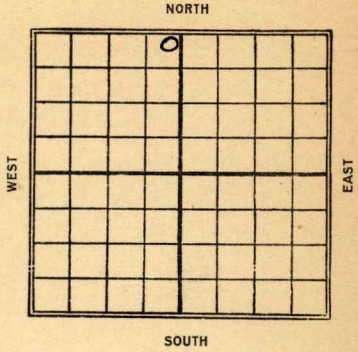

Date
1923
1/12

REPORT

D49-1894'

Map No. **KANSAS** Sec. **18** Twp. **22** R. **12**

Well No. **1 Maxwell**
Unknown Company

Contractor

ABANDONED SECTION PLAT

FIRST REPORT

200 Ft. from N. Line

Ft. from S. Line

200 Ft. from E. Line

Ft. from W. Line

| | | | |
|--|--|--|--|
| | | | |
| | | | |
| | | | |
| | | | |

Location

Rig up

Drilling and Remarks:

20+9
1894'

RECORD

Cased in, ft.

Sand

Gas

Oil

Total Depth

PRODUCTION

1st 24 hrs. Nat.

1st 24 hrs. after shot

Gas Cu. Ft.

Dry Hole

Abandoned

Date

JAN 12 1923

M. A. BENEAR

191

Scout