

Map No. 11 Sec. 18 Twp. 22 R. 10


Well No. 3 - Browning Farm
Rhodes & Shell Company

_____ Ft. from N. Line

330 Ft. from S. Line

990 Ft. from E. Line

_____ Ft. from W. Line

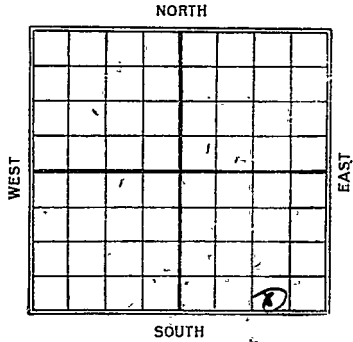

1924

REPORT

6/10

Reg up

7/9

23 54 84

150. Bblo -

70 2398'

21 KANSAS Map No. Sec. 18 Twp. 22 R. 10

Well No. 3 Brewing

R. Adams & Abel Company

Contractor

FIRST REPORT

SECTION PLAT

Ft. from N. Line

330 Ft. from S. Line

990 Ft. from E. Line

Ft. from W. Line

			0

Location

Rig up

Drilling and Remarks:

RECORD

Cased in., ft.

Sand

Gas

Oil

Total Depth

PRODUCTION

1st 24 hrs. Nat.

1st 24 hrs. after shot

Gas Cu. Ft.

Dry Hole

Abandoned

Date JUN 10 1924

M. A. BENEAR

192 Scout

Map No. 21 KANSAS Sec. 18 Twp. 22 R. 10

Well No. 3 Browning

Rhodes & Abell Company

Contractor

CONCRETE SECTION PLAT

_____ Ft. from N. Line

330 Ft. from S. Line

990 Ft. from E. Line

_____ Ft. from W. Line

			0

Location _____

Rig up _____

Drilling and Remarks:

sand 2354-84
J.D. 2398
150 fms
NAV,

RECORD

Cased _____ in., _____ ft.

Sand _____

Gas _____

Oil _____

Total Depth _____

PRODUCTION

1st 24 hrs. Nat. _____

1st 24 hrs. after shot _____

Gas _____ Cu. Ft.

Dry Hole _____

Abandoned _____

Date

JUL 9 1924

W. A. BENEAR

Scout