


Map No. Kansas Sec. 18 Twp. 22 R. 11
 Well No. 2-Clifton Farm
J. K. Simmons Company

_____ Ft. from N. Line

250 Ft. from S. Line

_____ Ft. from E. Line

940 Ft. from W. Line

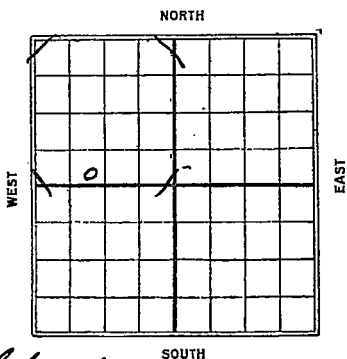

1926

Offsch

Date	REPORT
<u>4/21</u>	<u>Timbers</u>
<u>4/30</u>	<u>Bldg Rig</u>
<u>5/8</u>	<u>Same.</u>
<u>5/12</u>	<u>Rign up.</u>
<u>5/19</u>	<u>Spud + S.O.</u>
<u>6/2</u>	<u>_____</u>
<u>6/10</u>	<u>_____</u>
<u>6/18</u>	<u>_____</u>
<u>6/25</u>	<u>_____</u>
<u>6/30</u>	<u>Only 835</u>
<u>7/18</u>	<u>" 1200</u>
<u>7/15</u>	<u>" 1700</u>
<u>7/22</u>	<u>Land 2095-2111' T.D. 2114 700' O.I.H. natural, shot 40 qts. 1000' O.I.H. C.O.</u>
<u>7/28</u>	<u>Land 2095-2111, T.D. 2114 40/75 bbls.</u>

Sherwood

Map No. *K21* KANSAS Sec. *18* Twp. *22* R. *11*

Well No. *2* *Clifton*

Z. S. Simmons Company

Contractor

FIRST REPORTS

SECTION PLAT

.....Ft. from N. Line

250


.....Ft. from S. Line

.....Ft. from E. Line

940

.....Ft. from W. Line

offset

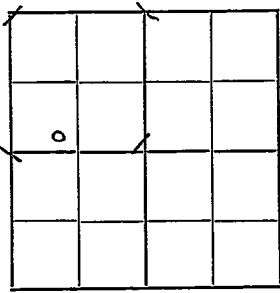

Location *Simmons*

Rig up

Drilling and Remarks:

RECORD

Cased.....in.,ft.

Sand

Gas

Oil

Total Depth.....

PRODUCTION

1st 24 hrs. Nat.

1st 24 hrs. after shot

Gas.....Cu. Ft.

Dry Hole.....

Abandoned.....

Date

APR 21 1926

CHAS. L. SHERWOOD

192

Scout

Greenwood

Map No. *K21* KANSAS Sec. *18* Twp. *22* R. *11*

Well No. *2* *Chopton*

F. H. Timmons Company

Contractor

COMPLETED.

SECTION PLAT

Ft. from N. Line

250

Ft. from S. Line

Ft. from E. Line

946

Ft. from W. Line

<i>0</i>			

Location -----

Rig up -----

Drilling and Remarks:

40975 *PS*

RECORD

Cased _____ in., _____ ft.

Sand *2095-2111'*

Gas -----

Oil -----

Total Depth *2114*

PRODUCTION

1st 24 hrs. Nat. -----

1st 24 hrs. after shot -----

Gas ----- Cu. Ft.

Dry Hole -----

Abandoned -----

Date

JUL 28 1926

CHAS. L. SHERWOOD
Scout