

Greenwood

Map No. KANSAS Sec. 18 Twp. 22 R. 11E

Well No. 4 Clopton Farm


T. K. Simmons Company

_____ Ft. from N. Line

990 Ft. from S. Line

_____ Ft. from E. Line

990 Ft. from W. Line

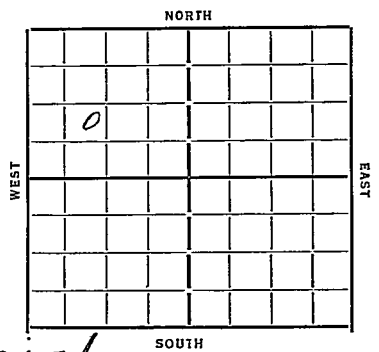

Special

Date
1933

REPORT

10/11 machine

10/18 Wrlg 300'

10/25 S.D. 1135

11/1 Wrlg 1600

11/8 Sand 2065 T.D. 2090

show oil - will shoot

11/15 ~~Wrlg~~ Sand 2065 T.D. 2134

P.B. 2125 100 gtn shot

50 bolts

COMPLETED

Map No. 21 Sec. 18 Twp. 22 R. 11E

Well No. 4 - Clapton

T. K. Simmons Company

Contractor

FIRST REPORTS

..... Ft. from N. Line

990 Ft. from S. Line

..... Ft. from E. Line

990 Ft. from W. Line

SPECIAL

SECTION PLAT

0			

Location.....

Rig up.....

Drilling and Remarks:

Machmic

RECORD

Cased.....in.,ft.

Sand.....

Gas.....

Oil.....

Total Depth.....

PRODUCTION

1st 24 hrs. Nat.....

1st 24 hrs. after shot.....

Gas.....Cu. Ft.

Dry Hole.....

Abandoned.....

Date

10-11-33 192

O. Manniched Scout

Map No. 21 Sec. 18 Twp. 22 R. 11E

Well No. 4 - Clapton

T. K. Simmons Company

Contractor

SECTION PLAT

~~COMPLETED~~
990 Ft. from N. Line

..... Ft. from S. Line

..... Ft. from E. Line

990 Ft. from W. Line

0			

Location.....

Rig up.....

Drilling and Remarks:

P.B. 2125

100 qt shot

50 bbls

RECORD

Cased..... in., ft.

Sand 2065

Gas.....

Oil.....

Total Depth 2134

PRODUCTION

1st 24 hrs. Nat.....

1st 24 hrs. after shot.....

Gas..... Cu. Ft.

Dry Hole.....

Abandoned.....

Date

11-15-33 192

O. Manschreck Scout