


Greenwood ✓
 Map No. 18 Sec. 18 Twp. 22 R. 11
 Well No. 5 Clopton Farm
J. R. Simmons Company

NORTH

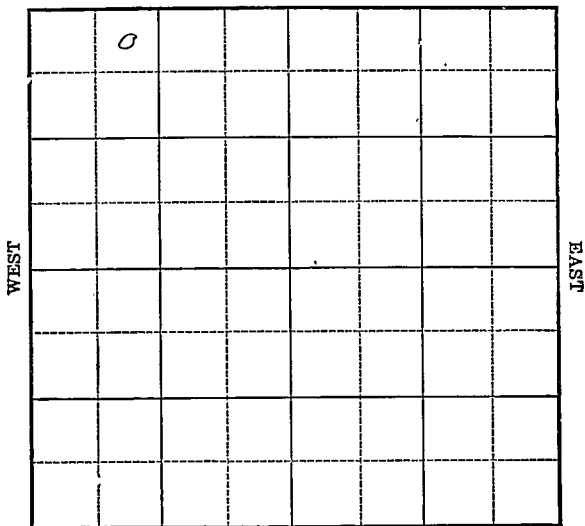

SOUTH

Location _____
 Drilling Remarks _____

Rig Up _____
 Drilling Remarks _____

RECORD

Cased _____ in. _____ ft.
 Sand _____
 Gas _____
 Oil _____
 Total Depth _____


PRODUCTION

1st 24 hrs. Nat. _____
 1st 24 hrs. after shot _____
 Gas _____ cu. ft.
 Dry Hole _____
 Abandoned _____

Map No. Trans Greenwood Sec. 18 Twp. 2 2 R. 11Well No. 5 Clopton FarmT. N. Simmons Company330 Ft. from N. Line

_____ Ft. from S. Line

_____ Ft. from E. Line

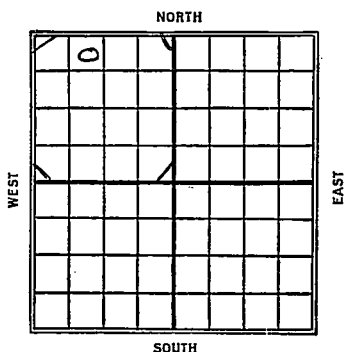990 Ft. from W. Line1926

Date

REPORT

10/20	Ro.G.
10/27	Rigging up
11/11	Drill 600
11/17	" 820
11/23	" 1200
12/8	sd 2126'-2154'. T.D. 2155'
	120/ 75 bbls

Greenwood
 21 KANSAS
 Map No. _____ Sec. 18 Twp. 22 R. 11
 Well No. 5 Chopton
 T. B. Simmons Company
 _____ Contractor

FIRST REPORTS

SECTION PLAT

330			
990			

_____ Ft. from N. Line

_____ Ft. from S. Line

_____ Ft. from E. Line

_____ Ft. from W. Line

Location _____

Rig up _____

Drilling and Remarks:

No 4

RECORD

Cased _____ in., _____ ft.

Sand _____

Gas _____

Oil _____

Total Depth _____

PRODUCTION

1st 24 hrs. Nat. _____

1st 24 hrs. after shot _____

Gas _____ Cu. Ft.

Dry Hole _____

Abandoned _____

Date

OCT 20 1926

CHAS. L. SHERWOOD
Scout

Sherrwood
21 KANSAS
 Map No. _____ Sec. *18* Twp. *22* R. *11*
 Well No. *5* *Clapton*
T. H. Simmons Company

Contractor _____

COMPLETED

SECTION PLAT

330

Ft. from N. Line

Ft. from S. Line

Ft. from E. Line

990

Ft. from W. Line

<i>0</i>			

Location _____

Rig up _____

Drilling and Remarks:

124 / 75 BS.

RECORD

Cased _____ in., _____ ft.

Sand *2126-2154*

Gas _____

Oil _____

Total Depth *2155*

PRODUCTION

1st 24 hrs. Nat. _____

1st 24 hrs. after shot _____

Gas _____ Cu. Ft.

Dry Hole _____

Abandoned _____

Date

DEC 8 1926

CHAS. L. SHERWOOD

192

Scout