


Map No. Kansas Sec. 18 Twp. 22 R. 11

Well No. 4 Clapton Farm \_\_\_\_\_  
Mid Continent Petr Company

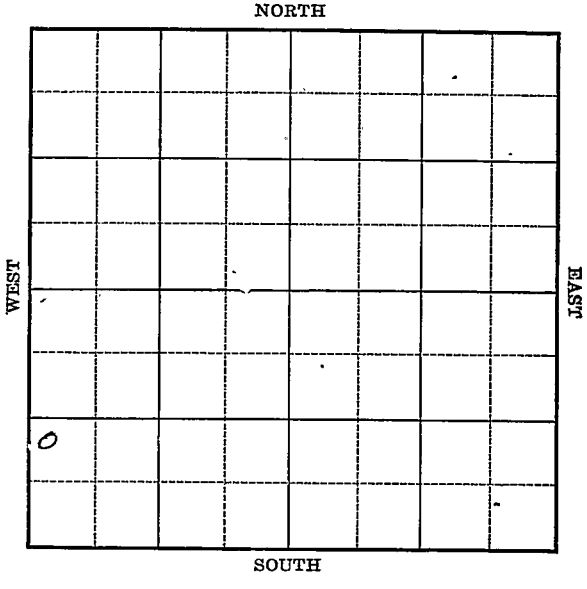

13

Location \_\_\_\_\_

Drilling Remarks \_\_\_\_\_

\_\_\_\_\_

\_\_\_\_\_

Rig Up \_\_\_\_\_

Drilling Remarks \_\_\_\_\_

\_\_\_\_\_

\_\_\_\_\_

**RECORD**

Cased \_\_\_\_\_ in. \_\_\_\_\_ ft.

Sand \_\_\_\_\_

Gas \_\_\_\_\_

Oil \_\_\_\_\_

Total Depth \_\_\_\_\_

**PRODUCTION**

1st 24 hrs. Nat. \_\_\_\_\_

1st 24 hrs. after shot \_\_\_\_\_

Gas \_\_\_\_\_ cu. ft.

Dry Hole \_\_\_\_\_

Abandoned \_\_\_\_\_



*Menasco Co*

Map No. *21* KANSAS Sec. *18* Twp. *22* R. *11*

Well No. *4 Clapton*

*Mid-Continent Oil Corp* Company

Contractor

FIRST REPORTS

SECTION PLAT

\_\_\_\_\_ Ft. from N. Line

*1080* Ft. from S. Line

\_\_\_\_\_ Ft. from E. Line

*250* Ft. from W. Line


Location \_\_\_\_\_

Rig up \_\_\_\_\_

Drilling and Remarks:

*Blg rig*

RECORD

Cased \_\_\_\_\_ in., \_\_\_\_\_ ft.

Sand \_\_\_\_\_

Gas \_\_\_\_\_

Oil \_\_\_\_\_

Total Depth \_\_\_\_\_

PRODUCTION

1st 24 hrs. Nat. \_\_\_\_\_

1st 24 hrs. after shot. \_\_\_\_\_

Gas \_\_\_\_\_ Cu. Ft.

Dry Hole \_\_\_\_\_

Abandoned \_\_\_\_\_

Date

AUG 27 1925

CHAS. L. SHERWOOD

Scout

W. Sherwood Co

K 21 KANSAS Sec 18 Twp. 22 R. 11

Well No. 4 Clapton

Mid-Cont Oil Corp Company

Contractor

COMPLETED

SECTION PLAT

\_\_\_\_\_ Ft. from N. Line

1080 Ft. from S. Line

\_\_\_\_\_ Ft. from E. Line

750 Ft. from W. Line


Location \_\_\_\_\_

Rig up \_\_\_\_\_

Drilling and Remarks:

1st oil 2102'

90/40 bhs.

RECORD

Cased \_\_\_\_\_ in., \_\_\_\_\_ ft.

Sand 2093-2136'

Gas \_\_\_\_\_

Oil \_\_\_\_\_

Total Depth 2136'

PRODUCTION

1st 24 hrs. Nat: \_\_\_\_\_

1st 24 hrs. after shot \_\_\_\_\_

Gas \_\_\_\_\_ Cu. Ft.

Dry Hole \_\_\_\_\_

Abandoned \_\_\_\_\_

Date OCT 29 1925

CHAS. L. SHERWOOD Scout