


Greenwood

Map No. **KANSAS** Sec. 18 Twp. 22 R. 11E

Well No. 8 Clopton Farm
T K Simmons Company

1070 Ft. from N. Line
____ Ft. from S. Line
1070 Ft. from E. Line
____ Ft. from W. Line

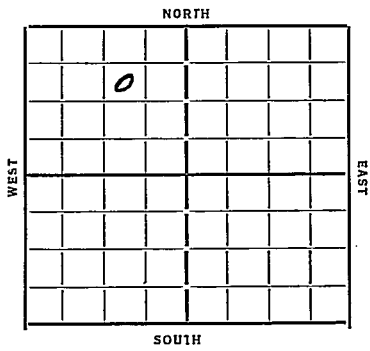

Date 1924

REPORT

<u>9/26</u>	<u>Machine</u>		
<u>10/4</u>	<u>Run up.</u>		
<u>10/11</u>			
<u>10/18</u>	<u>dy 725</u>	<u>12"</u>	<u>390</u>
<u>10/25</u>	<u>" 1500</u>	<u>10"</u>	<u>1172</u>
<u>11/1</u>	<u>" 1880</u>		
<u>11/7</u>	<u>TML 219'8"</u>	<u>T 2210</u>	<u>DFA</u>

ABANDONED

Map No. 21 Sec. 18 Twp. 22 R. 11 E

Well No. G. Clifton

T. K. Simmons Company

Contractor

SECTION PLAT

	0		

1070 Ft. from N. Line

_____ Ft. from S. Line

1070 Ft. from E. Line

_____ Ft. from W. Line

FIRST REPORTS

Location _____

Rig up _____

Drilling and Remarks:

Machine

RECORD

Cased _____ in., _____ ft.

Sand _____

Gas _____

Oil _____

Total Depth _____

PRODUCTION

1st 24 hrs. Nat. _____

1st 24 hrs. after shot _____

Gas _____ Cu. Ft.

Dry Hole _____

Abandoned _____

Date

9-26-37 19

ORVAL MANNSCHRECK

Scout

Greenwood

Map No. 21 Sec. 18 Twp. 22 R. 11E

Well No. 8-Clopton

J. K. Simmons Company

KANSAS Contractor

ABANDONED

SECTION PLAT

1070 Ft. from N. Line

..... Ft. from S. Line

1070 Ft. from E. Line

..... Ft. from W. Line

	0		
		A.	

Location.....

Rig up.....

Drilling and Remarks:

W + A

RECORD

Cased..... in., ft.

Sand T.M.L. 2198

Gas.....

Oil.....

Total Depth 2210

PRODUCTION

1st 24 hrs. Nat.....

1st 24 hrs. after shot.....

Gas..... Cu. Ft.

Dry Hole.....

Abandoned.....

Date

10-7-37 192

ORVAL MANSCHRECK

Scout