


Greenwood

Map No. **KANSAS** Sec. *18* Twp. *22* R. *11*

Well No. *7 C. Capton* Farm
Mid-Continent Pet Company

NORTH

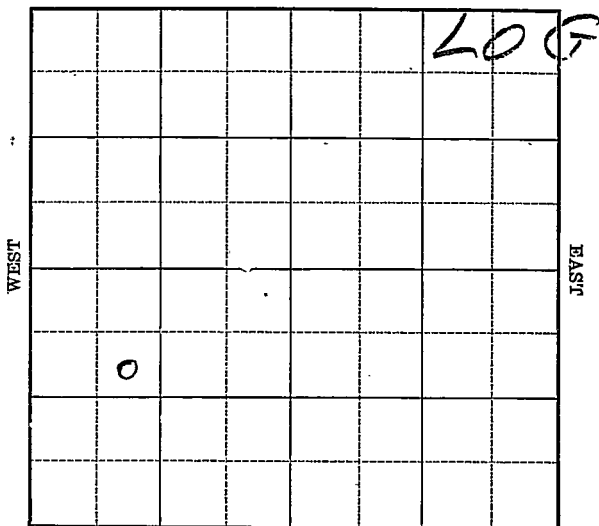

12

Location _____

Rig Up _____

Drilling Remarks _____

Drilling Remarks _____

RECORD

PRODUCTION

Cased _____ in. _____ ft.

1st 24 hrs. Nat. _____

Sand _____

1st 24 hrs. after shot _____

Gas _____

Gas _____ cu. ft.

Oil _____

Dry Hole _____

Total Depth _____

Abandoned _____

Sherwood Co


Map No. **21** KANSAS Sec. **18** Twp. **22** R. **11**

Well No. **7** *Clapton*
Mid-Cont Prod Corp. Company

Contractor

SECTION PLAT

990 Ft. from N. Line
 _____ Ft. from S. Line
 _____ Ft. from E. Line
990 Ft. from W. Line

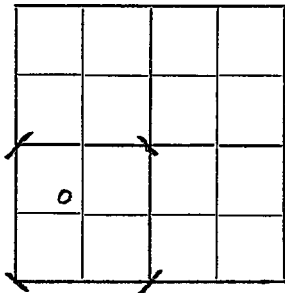

FIRST REPORTS

Location _____

Rig up _____

Drilling and Remarks:

Rigging up

RECORD

Cased _____ in., _____ ft.
 Sand _____
 Gas _____
 Oil _____
 Total Depth _____

PRODUCTION

1st 24 hrs. Nat. _____
 1st 24 hrs. after shot. _____
 Gas _____ Cu. Ft.
 Dry Hole _____
 Abandoned _____

Date

JAN 27 1926

CHAS. L. SHERWOOD

Greenwood

K21 KANSAS
 Map No. _____ Sec. *18* Twp. *22* R. *11*

Well No. *7 Clapton*

Mid-Cont. Pet. Corp. Company

Contractor

COMPLETED

SECTION PLAT

990 Ft. from N. Line

_____ Ft. from S. Line

_____ Ft. from E. Line

990 Ft. from W. Line

Location _____

Rig up _____

Drilling and Remarks:

6 5/8' 2062'

1st oil 2069'

pumping 50 lbs Nat.

RECORD

Cased _____ in., _____ ft.

Sand *2069-2089*

Gas _____

Oil _____

Total Depth *2091*

PRODUCTION

1st 24 hrs. Nat. _____

1st 24 hrs. after shot _____

Gas _____ Cu. Ft.

Dry Hole _____

Abandoned _____

Date

MAR 1 1 1926

CHAS. L. SHERWOOD

192

Scout