


Greenwood
LOG ✓

Map No. *KANS* Sec. *18* Twp. *22* R. *11*

Well No. *11* *Clopton* Farm

Mid-Cont Pet Corp Company

NORTH

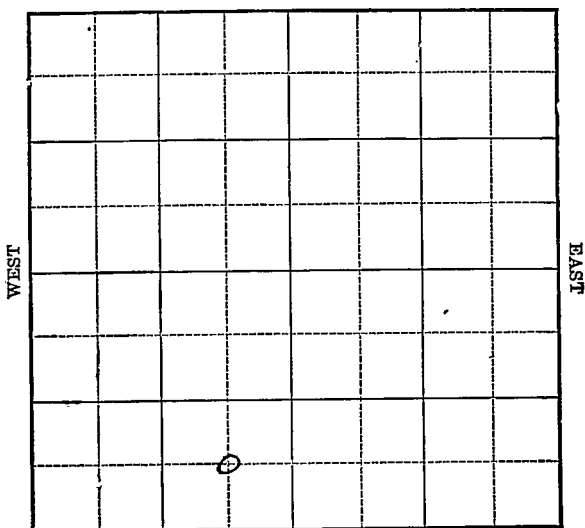

14

Location _____

Drilling Remarks

Rig Up _____

Drilling Remarks

RECORD

Cased _____ in. _____ ft.

Sand _____

Gas _____

Oil _____

Total Depth _____

PRODUCTION

1st 24 hrs. Nat. _____

1st 24 hrs. after shot _____

Gas _____ cu. ft.

Dry Hole _____

Abandoned _____

K21 KANSAS

Map No. _____ Sec. 18 Twp. 22 R. 11

Well No. 11 @ Clapton

Mid-Cont Pet Corp Company

Contractor

FIRST REPORTS

SECTION PLAT

_____ Ft. from N. Line

660 Ft. from S. Line

660 Ft. from E. Line

_____ Ft. from W. Line

	0		

Location _____

Rig up _____

Drilling and Remarks:

Blow by

RECORD

Cased _____ in., _____ ft.

Sand _____

Gas _____

Oil _____

Total Depth: _____

PRODUCTION

1st 24 hrs. Nat. _____

1st 24 hrs. after shot _____

Gas _____ Cu. Ft.

Dry Hole _____

Abandoned _____

Date

JUN 30 1926

CHAS. L. SHERWOOD

192

Scout

