


*Greenwood*

Map No. 15ans Sec. 18 Twp. 22 R. 11

Well No. 12 - Clopton Farm  
Mid - Cont Res Company

NORTH

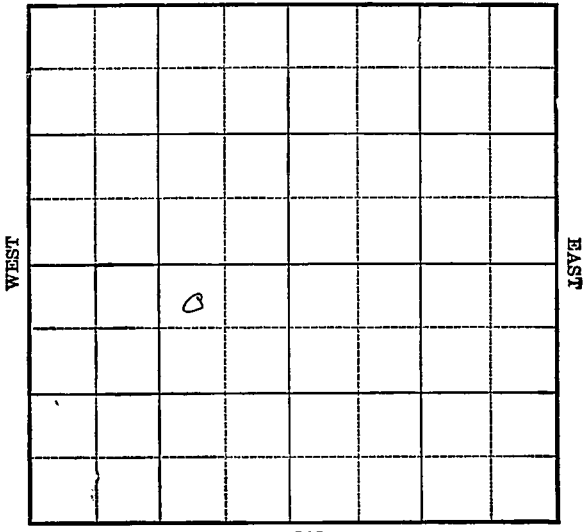

Location \_\_\_\_\_

Rig Up \_\_\_\_\_

Drilling Remarks \_\_\_\_\_

Drilling Remarks \_\_\_\_\_

\_\_\_\_\_

\_\_\_\_\_

**RECORD**

**PRODUCTION**

Cased \_\_\_\_\_ in. \_\_\_\_\_ ft.

1st 24 hrs. Nat. \_\_\_\_\_

Sand \_\_\_\_\_

1st 24 hrs. after shot \_\_\_\_\_

Gas \_\_\_\_\_

Gas \_\_\_\_\_ cu. ft.

Oil \_\_\_\_\_

Dry Hole \_\_\_\_\_

Total Depth \_\_\_\_\_

Abandoned \_\_\_\_\_



*Greenwood*

21 KANSAS  
Map No. \_\_\_\_\_ Sec. *18* Twp. *22* R. *11*

Well No. *12* *Clifton*

*MID-CONT Pet Corp* Company

Contractor

FIRST REPORTS

SECTION PLAT

*230*

\_\_\_\_\_ Ft. from N. Line

\_\_\_\_\_ Ft. from S. Line

*990*

\_\_\_\_\_ Ft. from E. Line

\_\_\_\_\_ Ft. from W. Line

<i>✓</i>	<i>0</i>	<i>✓</i>	

Location *✓* \_\_\_\_\_

Rig up \_\_\_\_\_

Drilling and Remarks:

RECORD

Cased \_\_\_\_\_ in., \_\_\_\_\_ ft.

Sand \_\_\_\_\_

Gas \_\_\_\_\_

Oil \_\_\_\_\_

Total Depth \_\_\_\_\_

PRODUCTION

1st 24 hrs. Nat. \_\_\_\_\_

1st 24 hrs. after shot. \_\_\_\_\_

Gas \_\_\_\_\_ Cu. Ft.

Dry Hole \_\_\_\_\_

Abandoned \_\_\_\_\_

Date \_\_\_\_\_

SEP 22 1926

CHAS. L. SHERWOOD

Scout

*Sherwood*

21 KANSAS Map No. Sec. 18 Twp. 22 R. 11

Well No. 12 *Lepton*

*Mid-Cont pet Co.* Company

Contractor

COMPLETED

SECTION PLAT

330 Ft. from N. Line

Ft. from S. Line

990 Ft. from E. Line

Ft. from W. Line

	0		

Location

Rig up

Drilling and Remarks:

35 *PS Natural*

RECORD

Cased \_\_\_\_\_ in., \_\_\_\_\_ ft.

Sand *2090-2109*

Gas \_\_\_\_\_

Oil \_\_\_\_\_

Total Depth *2109*

PRODUCTION

1st 24 hrs. Nat. \_\_\_\_\_

1st 24 hrs. after shot \_\_\_\_\_

Gas \_\_\_\_\_ Cu. Ft.

Dry Hole \_\_\_\_\_

Abandoned \_\_\_\_\_

Date NOV 23 1926

CHAS. L. SHERWOOD

192 Scout