


LOG

Map No. 7 Sec. 18 Twp. 22 R. 11

Well No. 1 J. D. Clopton Farm _____
Cosden Oil & Gas Company

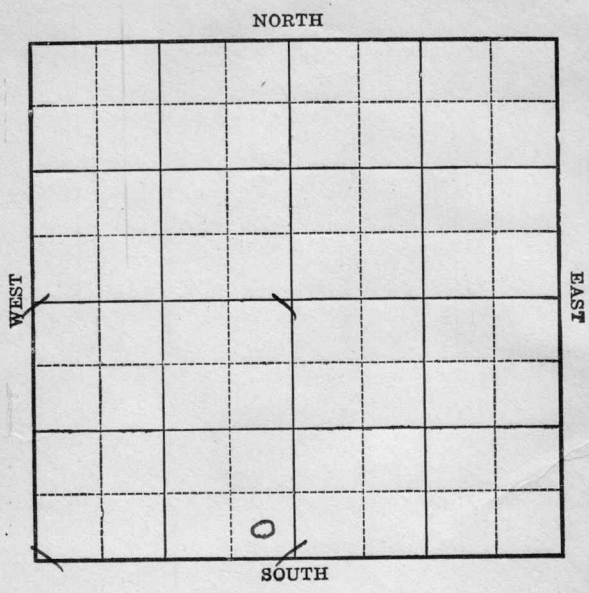

14

Location _____

Rig up _____

Drilling Remarks:

Drilling Remarks:

RECORD

PRODUCTION

Cased _____ in. _____ ft.

Sand _____

Gas _____

Oil _____

Total Depth _____

1st 24 hrs Nat. _____

1st 24 hrs. after shot _____

Gas _____ cu. ft.


Dry Hole _____

Abandoned _____

Map No. Sec. 18 Twp. 22 R. 11

Well No. 1 G. D. Clopton Farm
Cosden Oil & Gas Company

_____ Ft. from N. Line
330 Ft. from S. Line
330 Ft. from E. Line
_____ Ft. from W. Line

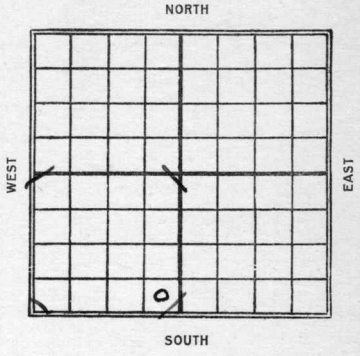

Date
1923
7/24
10/26

REPORT

Location (N).
Total depth 2086 -
130 Bbls.

