


DX 78-1

Section 18 Township 22 Range 11E
Well No. #19 Clopton
Company Geo. Sheehan

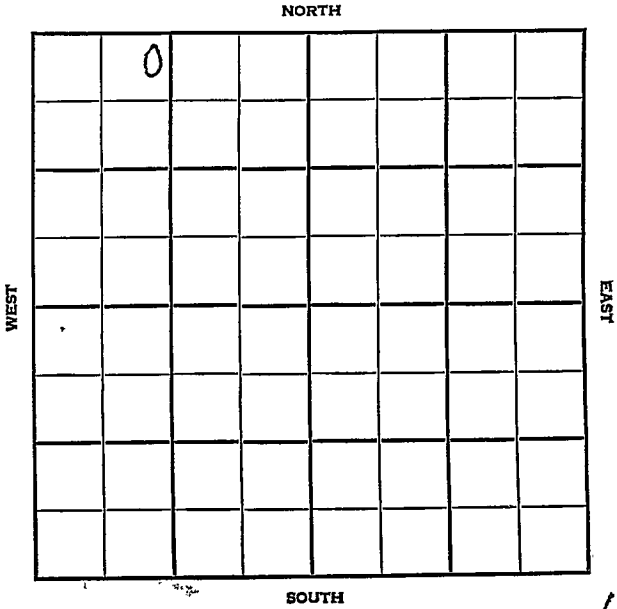

SEC.	TWP.	R.
18	22	11E

WELL NO.

#19 Clopton

FARM

COMPANY

Geo. Sheehan

CONTRACTOR

DeMalorie-Sowder


DeMalorie-Sowder Pool

30 Ft. from N. Line

Ft. from S. Line

Ft. from E. Line

1125 Ft. from W. Line

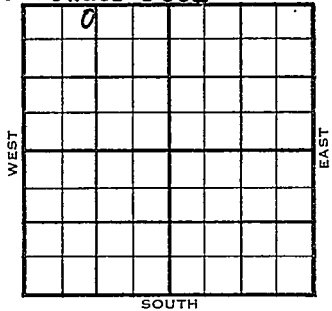

NE NE NW NW

	ELEVATION	REPORT
1955	-	

4/6 Spud 3-24-55
 8" @ 40'
 Doug. 1088', B. Doug. 1180', Bart.
 2104',
 Ø 2090' - 2108'
 TD 2090'
 4" @ 2104'
 DD 2118

4/20 Spud 3-24-55 - Input Well
 TD 2149'
 8" @ 40'
 Doug. 1088', B. Doug. 1180', Bart
 2104'
 TD 2090'
 4" @ 2104'
 DD 2118', DD 2149', PB 2134'
 Input 125 bw 24 hrs.

ABANDONED

County Greenwood State Kansas

Sec. 18 (Blk. Twp.) 22 (Sur. Rge.) 11E Map No.

Operator Geo. Sheehan

Well No. 19 Farm Clonton

Elev. Location NE NE NW NW

0					

30 Ft. From N Line NW

1125 Ft. From W Line Quarter

Ist. Report APR 6 1955

Completion _____

Remarks _____

Spudding Date 3-24-55

Drlg. Data DeMalorie-Sowder Pool

8" @ 40 Doug. 1088 B. Doug. 1180

Bart. 2104 Core 2090-2108 TD 2090

4" @ 2104 DD 2118

FABEN GILSTRAP

County Greenwood State Kansas

Sec. 18 (Blk. 22) (Sur. 11E) (Twp.) (Rge.) Map No.

Operator Geo. Sheehan

Well No. 19 Farm Clopton

Elev. Location NE NE NW NW

30 Ft. From N Line NW

1125 Ft. From W Line Quarter

Ist. Report

Completion APR 20 1955

Remarks DeMalorie-Sowder

Spudding Date 3-24-55

Drig. Data Input well TD 2149

8" @ 40 Doug. 1088 B. Doug. 1180

Bart. 2104 TD 2090 4" @ 2104 DD 2118

DD 2149 PB 2134 Input 125 bw 24 hr.

FABEN GILSTRAP