
LOG

Form 51 5M 11-23 13896

Map No. Kansas Sec. 18 Twp. 22 R. 11 W

Well No. #3 J. D. Clapton Farm

Cobden. Company

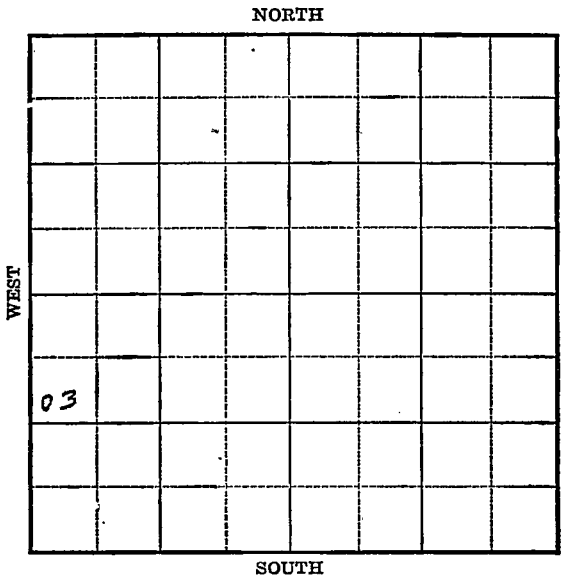

12

Location _____

Drilling Remarks:

Rig Up _____

Drilling Remarks:

RECORD

Cased _____ in. _____ ft.

Sand _____

Gas _____

Oil _____

Total Depth _____

PRODUCTION

1st 24 hrs. Nat. _____

1st 24 hrs. after shot _____

Gas _____ cu. ft.

Dry Hole _____

Abandoned _____

Form 26—1M Bks.—3-23—11959.

3 Kansas

Map No. _____ Sec. 18 Twp. 22 R. 11

Well No. #3 J. D. Clapton

Osden

_____ Company

_____ Contractor

FIRST REPORT


910 Ft. from N. Line

_____ Ft. from S. Line

_____ Ft. from E. Line

250 Ft. from W. Line

SECTION PLAT

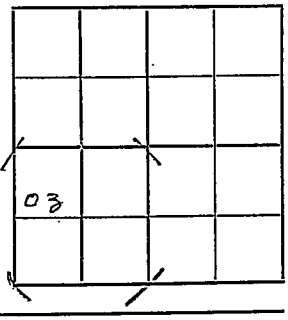

Location L

Rig up _____

Drilling and Remarks:

Mills
destroy

RECORD

Cased _____ in., _____ ft.

Sand _____

Gas _____

Oil _____

Total Depth _____

PRODUCTION

1st 24 hrs. Nat. _____

1st 24 hrs. after shot _____

Gas _____ Cu. Ft.

Dry Hole _____

Abandoned _____

Date

_____ 192____. _____ Scout