

Sec. 18 Twp. 22 S R. 11 E

Well No. # 22 J. D. Clopton Farm

Mid-Continent Petroleum Company

Jackman & Jackman Contractor

Saunder Pool


Ft. from N. Line

360 Ft. from S. Line

Ft. from E. Line

974 Ft. from W. Line

SE SW SW

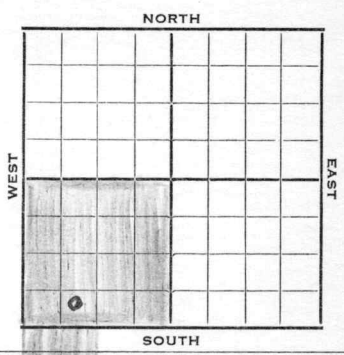

Elev. - REPORT

1953	Location Notice	
7/12	Location (F.R. Ticket)	
7/14	Spudded 7-13-53	
7/15	8-5/8" @ 48 w/350 sax.	
	Drlg. 368'	(DR)
7/16	TD 368' No report	"
7/17	Drlg. 1440'	"
7/20	TD 2057'	
	5 1/2" @ 2056 w/50 sax.	
	Top Bartlesville 2056'	"
7/21	TD 2057' WOC	"
7/22	TD 2057' WOC	"
7/23	TD 2057' MICT	"
7/24	TD 2057' RUCT	"
7/27	Drlg. 2080'. Prep to set pumping unit.	"
7/28	TD 2080'. Prep to set pumping unit.	"
7/29	TD 2080'. Prep to set pump unit.	"
7/30	TD 2080' Setting pumping unit.	"
7/31	TD 2080' Setting pumping unit.	"
8/3	TD 2080'. COMP. 8-3-53 10 BPD on pump.	"

OVER

1953
7/29

Spud 7-13-53 Oil well TD 2081
8" @ 47 Bart. 2057 TD 2060
5" @ 2057 DD 2081
Comp. 10 BOPD 5 BW

COMPLETED


County Greenwood State Kansas

Sec. 18 (Blk. 22) (Sur. 11E) (Twp.) (Rge.) Map No.

Operator Mid-Continent Pet.

Well No. 22 Farm Clopton

Elev. _____ Location SE SW SW

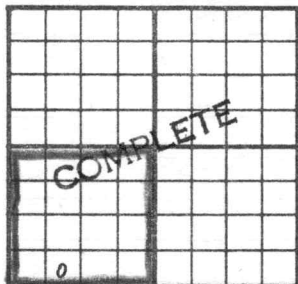

360 Ft. From S Line SW

974 Ft. From W Line Quarter

1st. Report _____

Completion JUL 29 1953

Remarks Sauder Pool

Jackman & Jackman - Contr.

Spudding Date 7-13-53

Drlg. Data Oil well TD 2081

8" @ 47 Bart. 2057 TD 2060 5" @ 2057

DD 2081 Comp. 10 bopd 5 bw


J. G. McGEHEE

LOCATION NOTICE

TULSA, OKLA., July 12, 1953 19.....

WELL NO. 22 ON J. D. Clopton FARM

WILL BE AS FOLLOWS:

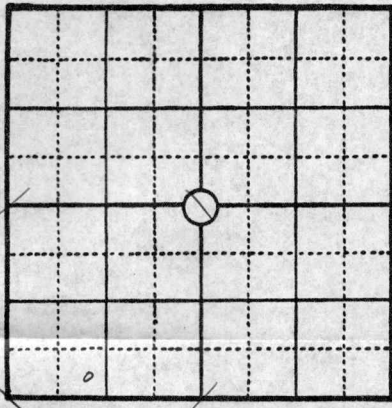

..... FEET FROM NORTH LINE
 FEET FROM EAST LINE
 360 FEET FROM SOUTH LINE
 97 1/2 FEET FROM WEST LINE

IN SW/4 SEC 18 TWP 22S RANGE 11E
Greenwood COUNTY, STATE OF Kansas

REMARKS: R. L. Mankey
B. F. Williams
M. C. P. C. -- 100%

SIGNED A. E. Pierce

- COPIES TO
- R. W. McDOWELL
 - DISTRICT SUPT.
 - ACCOUNTING DEPT.
 - ✓ SCOUTING DEPT.
 - GEOLOGICAL DEPT.
 - PIPE LINE DEPT.
 - MATERIALS DEPT.
 - RENTAL DEPT.
 - LEGAL DEPT.
 - LEO MEYER
 - INCOME TAX DEPT.
 - ENGINEERING DEPT.
 - LEASE INVENTORY
 - CLAIM DEPT.
 - J. W. BASORE
 - FILE

Card Typed - 7/17/53