


Section 18 Township 22 Range 11-E

Well No. #13, J. D. Clopton

Company Mid-Continent Petroleum Corporation

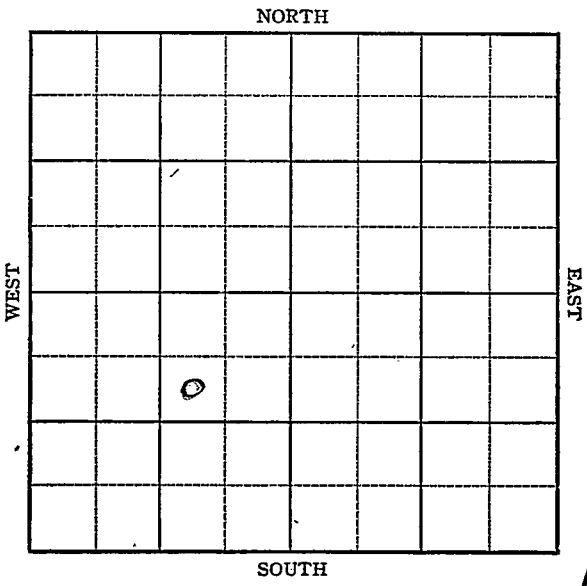

11

Sec. 18 Twp. 22-S R. 11-E

Well No. #13 J. D. Clopton Farm

Mid-Continent Petr. Corp. Company


Water Input well

1299 Ft. from N. Line

_____ Ft. from S. Line

1240 Ft. from E. Line

_____ Ft. from W. Line

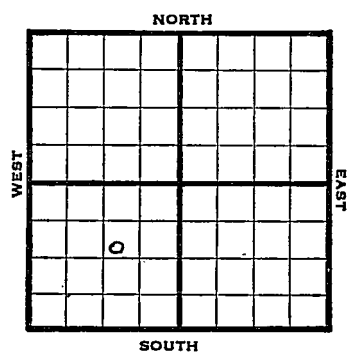

SW/4

1946 **REPORT**

11/21	Location notice only.	
11/26	9-5/8" set 28' with 10 sacks.	(P.R)
11/27	Drilling 300' (Ticket)	"
11/29	Drilling 1132'	"
12/2	Drilling 1510' Big Lime.	"
12/3	Drilling 1720'	"
12/4	Drilling 1900'	"
12/5	Total Depth 2077' Going in to core.	(Tel)
12/6	Coring 2077'	(P.R)
12/9	7" casing set 2077' with 150 sacks. WOC T.D. 2100'	"
12/10	WOC & tearing down tools Will move in spudder.	"
12/11	Moving in Cable tools.	"
12/12	" "	"
12/13	Bailing mud. Should drill cement today.	"
12/14	" " " "	"
12/16	T.D. 2100' Drld cement. CO to bottom Washing hole, bailing, & CO.	"
12/17	CO	"
12/18	Shooting with 8 qts glycerine. Will sand tamp.	"
12/19	Shot w/8 qts glycerin 2088-2076 CO	"

Over

1946

12/20 CO. Expect to finish tomorrow PR
12/23 Comp. 12-23-46
Water Input Well (PR)

1947

1/2 Bart 2082'
7" @ 2072'
TD 2105'
Water Repressure Well

ABANDONED

Map No. 21 Sec. 18 Twp. 22 R. 11E

Well No. 13 J. D. Clopton

Mid-Continent Petroleum Company

FIRST REPORT

Contractor

SW NE SW

SECTION PLAT

1299 Ft. from N. Line

_____ Ft. from S. Line

1240 Ft. from E. Line

_____ Ft. from W. Line

Greenwood County

Location _____

Rig up _____

Drilling and Remarks:

SWD

RECORD

Cased _____ in., _____ ft.

Sand _____

Gas _____

Oil _____

Total Depth _____

PRODUCTION

1st 24 hrs. Nat. _____

1st 24 hrs. after shot _____

Gas _____ Cu. Ft.

Dry Hole _____

Abandoned _____

Date

NOV 27 1946 19 _____

S. J. LEWIS Scout

Kansas

Map No. 21 Sec. 18 Twp. 22 R. 11EWell No. 13 J. D. CloptonMid-Continent Petroleum Company

ABANDONED

Contractor

SW NE SW

SECTION PLAT

1299 Ft. from N. Line

_____ Ft. from S. Line

1240 Ft. from E. Line

_____ Ft. from W. Line

Greenwood County

Location _____

Rig up _____

Drilling and Remarks:

Box 2082
7" @ 2072
Water Represent
Well

RECORD

Cased _____ in., _____ ft.

Sand _____

Gas _____

Oil _____

Total Depth 2105

PRODUCTION

1st 24 hrs. Nat. _____

1st 24 hrs. after shot _____

Gas _____ Cu. Ft.

Dry Hole _____

Abandoned _____

Date

JAN 2 1947 19

S. J. LEWIS Scout