
Location Notice Greenwood KANSAS

FORM 51 25M 3-49 PETROL

Section 18 Township 22 S Range 11 E

Well No. # 20 J. D. Clopton

Company Mid-Continent Petroleum Copp.

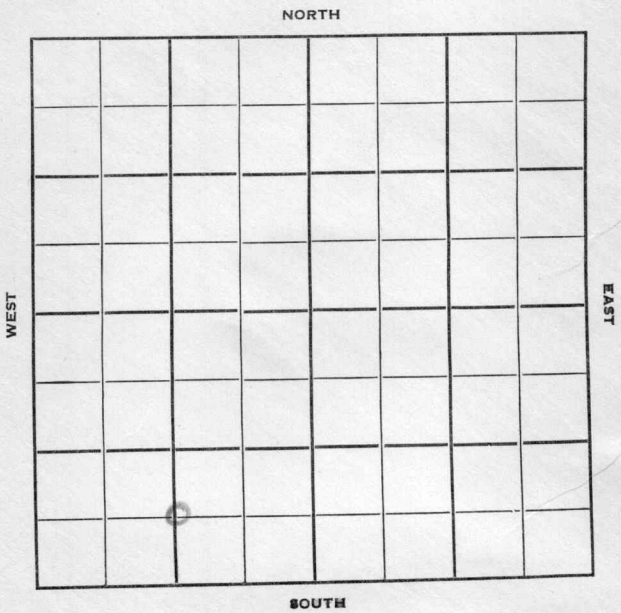

14

FORM 252-B
10M 8-51 TPCO.

HOT FILE

Greenwood KANSAS ✓

Sec. 18 Twp. 22 S R. 11 E

Well No. # 20 J. D. Clopton Farm

Mid-Continent Petroleum Company

Jackman & Jackman Contractor


Ft. from N. Line

660 Ft. from S. Line

Ft. from E. Line

1320 Ft. from W. Line

C S/2 SW

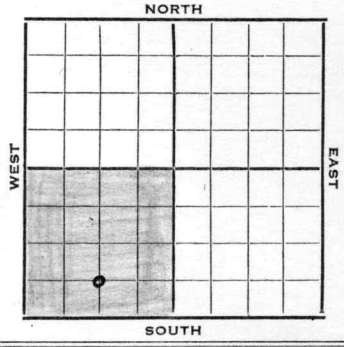

1952	Elev. - REPORT	
10/24	Location Notice	
10/27	RUR	(DR)
10/28	RUR	"
10/29	Drlg. 65' Spudded 10-28-52 8-5/8" @ 63' w/35 sax.	"
10/30	Drlg. 65'. WOC	"
10/31	TD 65'. WOC	"
11/3	Drlg. 1510'	"
11/4	Drlg. 1965'	"
11/5	Drlg. 2065' 4½" csg set 2064' w/50 sax. Top sand 2063½'	"
11/6	TD 2065'. WOC	"
11/7	TD 2065'. WOC	"
11/10	TD 2065'. WOC	"
11/12	TD 2065'. MICT. Bailing mud Will drill sand tomorrow.	" "
11/13	TD 2065'. No report	"
11/14	TD 2065'. Cleaning out.	"
11/17	TD2079'. COMP. 11-17-52 3 BPD on Pump.	"
12/17	~~COMPLETED~~ Spud 10-28-52 Oil well TD 2079' 8" @ ~~XXX~~ 63 Bart 2063' TD 2065' 4" @ 2064 CO to 2065 DD 2079' Comp. 10 BOPD 12 BW COMPLETED	

FORM 275 FOR SALE BY KANSAS BLUE PRINT CO.


County Greenwood State Kansas

Sec. 18 (Blk. Twp.) 22 (Sur. Rge.) 11E Map No.

Operator Mid-Continent Petroleum Corp.

Well No. 20 Farm Clopton

Elev. Location C S L SW/4

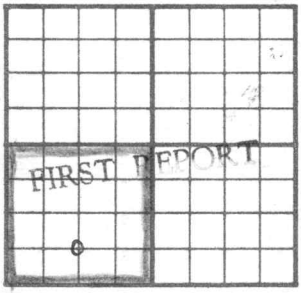

660 Ft. From S Line SW

1320 Ft. From W Line Quarter

1st. Report NOV 12 1952

Completion

Remarks Jackman & Jackman - Cont

Spudding Date 10-28-52

Drlg. Data

8" @ 63 Bart. 2063 TD 2065 4" @ 2064

WOCT

J. G. McGEHEE

FORM 275 FOR SALE BY KANSAS BLUE PRINT CO


County Greenwood State Kansas

Sec. 18 (Blk. Twp.) 22 (Sur. Rge.) 11E Map No.

Operator Mid-Continent Petroleum Corp.

Well No. 20 Farm Clopton

Elev. Location C S L SW/4

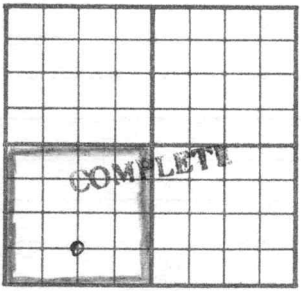

660 Ft. From S Line SW

1320 Ft. From W Line Quarter

1st. Report

Completion DEC 17 1952

Remarks

Jackman & Jackman - Contr

Spudding Date 10-28-52

Drlg. Data Oil well TD 2079

8" @ 63 Bart. 2063 TD 2065 4" @ 2064

CO to 2065 DD 2079

Comp. 10 bopd 12 bw

J. G. McGEHEE


Form 142-B 2M 6-51 Petrol

LOCATION NOTICE

TULSA, OKLA., Oct. 24, 1952, 19....

WELL NO. 20 ON J. D. Clopton FARM

WILL BE AS FOLLOWS:

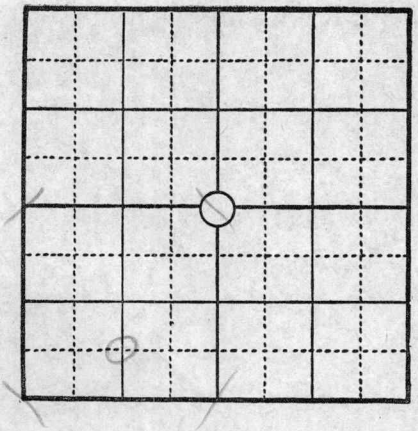

C S/2 SW

.....FEET FROM NORTH LINE

.....FEET FROM EAST LINE

660 FEET FROM SOUTH LINE

1320 FEET FROM WEST LINE

IN SW/4 SEC. 18 TWP. 22S RANGE 11E

Greenwood COUNTY, STATE OF Kansas

REMARKS: R. L. Mankey -- Dist. Supt.

R. F. Williams - Foreman

M. C. P. C. ---- 100%

SIGNED A. E. Pierce

W

COPIES TO

R. W. McDOWELL
DISTRICT SUPT.
ACCOUNTING DEPT.
SCOUTING DEPT.
GEOLOGICAL DEPT.
PIPE LINE DEPT.
MATERIALS DEPT.
RENTAL DEPT.
LEGAL DEPT.
LEO MEYER
INCOME TAX DEPT.
ENGINEERING DEPT.
LEASE INVENTORY
CLAIM DEPT.
J. W. BASORE
FILE

Card Typed.