


Map No. 21 KANS Sec. 18 Twp. 22 R. 11 ✓

Well No. 1 Hampe Farm

Simmons & Burke Company

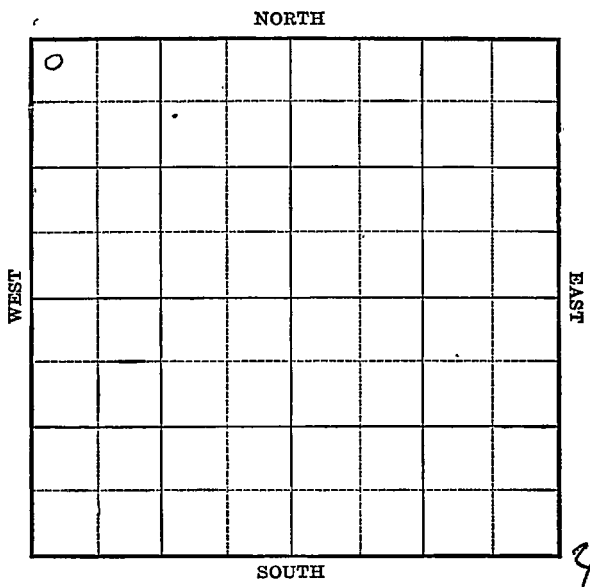

Location \_\_\_\_\_

Rig Up \_\_\_\_\_

Drilling Remarks:

Drilling Remarks:

\_\_\_\_\_

\_\_\_\_\_

**RECORD**

**PRODUCTION**

Cased \_\_\_\_\_ in. \_\_\_\_\_ ft.

1st 24 hrs. Nat. \_\_\_\_\_

Sand \_\_\_\_\_

1st 24 hrs. after shot \_\_\_\_\_

Gas \_\_\_\_\_

Gas \_\_\_\_\_ cu. ft.

Oil \_\_\_\_\_

Dry Hole \_\_\_\_\_

Total Depth \_\_\_\_\_

Abandoned \_\_\_\_\_



Map No. Kans<sup>21</sup> 18 Sec. 18 Twp. 22 R. 11

Well No. 1 - Hampe -  
Summons & Burke Company

Contractor

FIRST REPORTS

SECTION PLAT

260 Ft. from N. Line

----- Ft. from S. Line

----- Ft. from E. Line

200 Ft. from W. Line

0			

FIRST REPORTS

Location -----

Rig up ✓ ✓ -----

Drilling and Remarks:

0, 250'

RECORD

Cased ----- in., ----- ft.

Sand -----

Gas -----

Oil -----

Total Depth -----

PRODUCTION

1st 24 hrs. Nat. -----

1st 24 hrs. after shot -----

Gas ----- Cu. Ft.

Dry Hole -----

Abandoned -----

Date

7/23/4

192

W. B. Scout

Scout

21 **ANSAG** Map No. Sec. 18 Twp. 22 R. 11  
Well No. 1 *Hampel*  
*Simmons & Burke* Company

Contractor

# ABANDONED SECTION PLAT

200 Ft. from N. Line  
\_\_\_\_\_ Ft. from S. Line  
\_\_\_\_\_ Ft. from E. Line  
200 Ft. from W. Line

0			

Location \_\_\_\_\_

Rig up \_\_\_\_\_

Drilling and Remarks:

*2131-38 No. 1*  
*NOVA*  
*2201*

## RECORD

Cased \_\_\_\_\_ in., \_\_\_\_\_ ft.  
Sand \_\_\_\_\_  
Gas \_\_\_\_\_  
Oil \_\_\_\_\_  
Total Depth \_\_\_\_\_

## PRODUCTION

1st 24 hrs. Nat. \_\_\_\_\_  
1st 24 hrs. after shot \_\_\_\_\_  
Gas \_\_\_\_\_ Cu. Ft.  
Dry Hole \_\_\_\_\_  
Abandoned \_\_\_\_\_

Date

*AUG 26 1924*

192

**M. A. BENEAR**

Scout