

Section 19 Township 22 Range 4 EWell No. # 1 SlocumCompany Eldorado Ref.

0

13

EAST

WEST

SOUTH

Marion KANSAS ✓

Sec. 19 Twp. 22 R. 1E

Well No. #1 Slocum Farm

ElDorado Ref. Company

Rex & Morris Contractor


 Ft. from N. Line

990 Ft. from S. Line

 Ft. from E. Line

990 Ft. from W. Line

NE SW SW

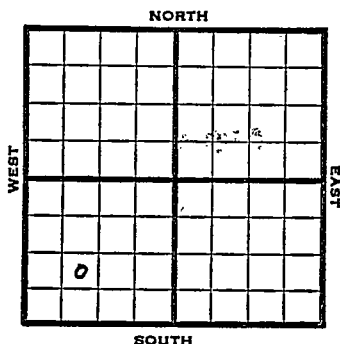

1953

Elev. 11436' REPORT

6/3

Loc.


6/17

Spud 6-9-53

D & A TD 2583' 8" @ 132

Miss 2543' TD 2583' D & A

ABANDONED

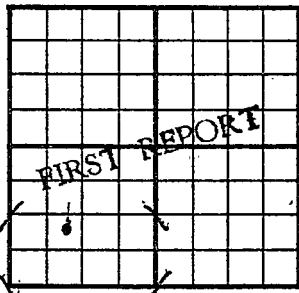County Marion State KansasSec. 19 (Blk.) 22 (Sur.) 4E (Twp.) 4E Map No.Operator Eldorado Ref.Well No. 1 Farm SlocumElev. Location NE SW SW990 Ft. From S Line SW990 Ft. From W Line Quarter1st. Report JUN 3 1953

Completion

Remarks

Rex & Morris - Contr.

Spudding Date

Drlg. Data


Location

County Marion State Kansas
 Sec. 19 (Blk.) 22 (Sur.) 4E Map No.

Operator Eldorado Ref.

Well No. 1 Farm Slocum

Elev. 1436 Location NE SW SW

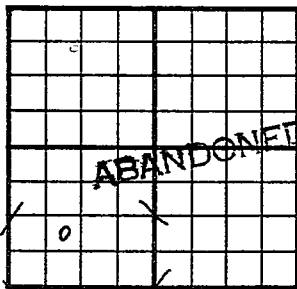

990 Ft. From S Line SW

990 Ft. From W Line Quarter

1st. Report

Completion JUN 17 1953

Remarks

Rex & Morris - Contr.

Spudding Date 6-9-53

Drlg. Data D & A TD 2583

8" @ 132 Miss. 2543 TD 2583

D & A

J. G. McGEHEE