

# KANSAS

Marion

Section 19 Township 22 Range 5E

Well No. 1 Koebele

Company H & M Drlg. et al

**Wildcat**

NORTH

<b>0</b>							

13

WEST


EAST

SOUTH

Sec. 19 Twp. 22 R. 5E ✓

Well No. #1 Koebels Farm  
H & M Drlg. et al Company  
Wildcat SW/C

\_\_\_\_\_ Ft. from N. Line  
330'  
\_\_\_\_\_ Ft. from S. Line  
\_\_\_\_\_ Ft. from E. Line  
330'  
\_\_\_\_\_ Ft. from W. Line  
SW/C

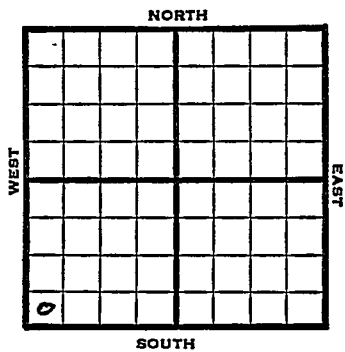

1949	REPORT
6/15	15" @ 130' Drlg. 1930'
6/21	13" @ 960' 10" @ 1252' Miss 2432'
6/29	Drlg. 2466' TD 2660' Viola 2660' Aband.
<b>ABANDONED</b>	

Marion County Kansas State

Map No. \_\_\_\_\_ Sec. 19 Twp. 22 R. 5E


Well No. 1 Koebele

H & M Drlg. etal. Company

Contractor

SW/C

FIRST REPORT  
SECTION PLAT

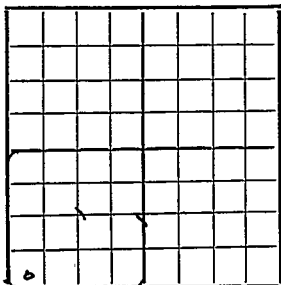

\_\_\_\_\_ Ft. from N. Line

330 Ft. from S. Line

\_\_\_\_\_ Ft. from E. Line

330 Ft. from W. Line

Wildcat

Remarks:

15" @ 130 drlg. 1930

Date  
JUN 15 1949

Scout S. J. LEWIS

