


Greenwood

Map No. **KANSAS** Sec. 19 Twp. 22 R. 12^E

Well No. 2 - Imthurn Farm
J. R. Simmons Company

NORTH

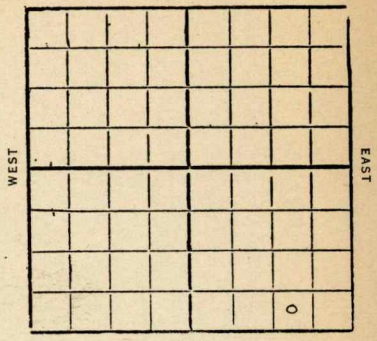

_____ Ft. from N. Line

330 Ft. from S. Line

990 Ft. from E. Line

_____ Ft. from W. Line

1930

SOUTH

Date

REPORT

12/23

Loc

12/30

1931

1/7

1/14

1/21

Machine

1/28

Dreg 630'

2/4

S.D. 630'

2/11

dreg 995'

2/18

" 1700'

2/25

Top line 1925

T.D. 1965

Dry & Abandon

Greenwood

21 KANSAS Sec. 19 Twp. 22 R. 12 E

Well No. 2 Inthurn

T. K. Simmons Company

Contractor

FIRST REPORTS

SECTION PLAT

Ft. from N. Line
330 Ft. from S. Line
990 Ft. from E. Line
Ft. from W. Line

Section plat grid with 4 columns and 4 rows, containing a small circle in the bottom right cell.

Location [check]
Rig up
Drilling and Remarks:

RECORD

Cased in., ft.
Sand
Gas
Oil
Total Depth

PRODUCTION

1st 24 hrs. Nat.
1st 24 hrs. after shot
Gas Cu. Ft.
Dry Hole
Abandoned

Date

DEC 23 1930

CHAS. L. SHERWOOD

192 Scout

Greenwood 71

Map No. **KANSAS** Sec. 19 Twp. 22 R. 12E

Well No. 2 Southern

T. K. Simmons Company

Contractor

SECTION PLAT

			0

..... Ft. from N. Line

330 Ft. from S. Line

990 Ft. from E. Line

..... Ft. from W. Line

ABANDONED

Location.....

Rig up.....

Drilling and Remarks:

Top line 1925

RECORD

Cased..... in., ft.

Sand.....

Gas.....

Oil.....

Total Depth 1965

PRODUCTION

1st 24 hrs. Nat.....

1st 24 hrs. after shot.....

Gas..... Cu. Ft.

Dry Hole.....

Abandoned.....

Date

FEB 25 1931

192

S. J. LEWIS

Scout