
Form 51 5M 8-24 16567

Map No. Kans Sec. 19 Twp. 22 R. 10 E

Well No. 2 Browning Farm

White Eagle Company

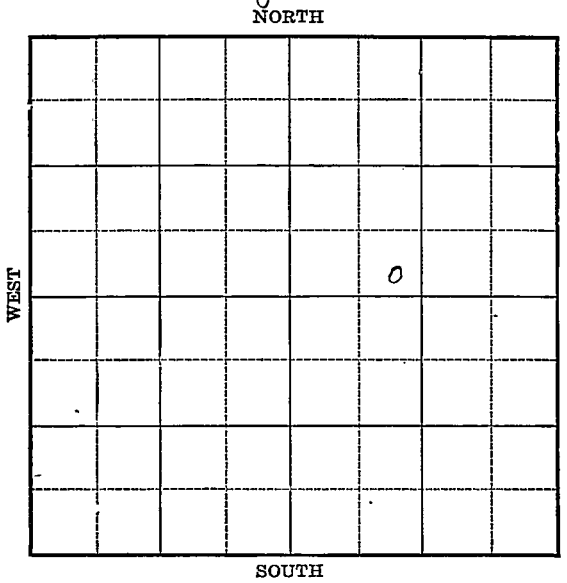



| | |
|---|---|
| Location | Rig Up |
| Drilling Remarks | Drilling Remarks |
| | |
| RECORD | PRODUCTION |
| Cased in. ft. | 1st 24 hrs. Nat. |
| Sand | 1st. 24 hrs. after shot |
| Gas | Gas cu. ft. |
| Oil | Dry Hole |
| Total Depth | Abandoned |

Form 252A 5M 8-24 16529

Map No. Kansas Sec. 19 Twp. 22 R. 10

Well No. 2 Browning Farm

White Eagle Company

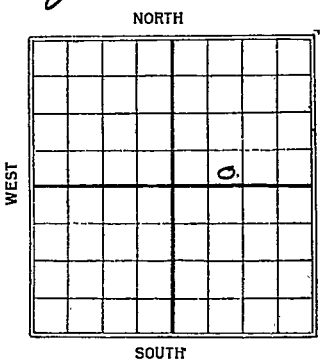


_____ Ft. from N. Line

330 Ft. from S. Line

_____ Ft. from E. Line

990 Ft. from W. Line

C.

| Date 1925 | REPORT |
|---|---|
| 4/6 | Rig |
| 5/29 | Dry Sand 2311 - 2323 |
| | T.D. 2390 |
| 6/5 | S. 2311-22 T.D. & Abd. 2405 |

Form 26—1M Bks.—3-23—11959.

Map No. 21 Sec. 19 Twp. 22 R. 10 E


Well No. 2 Browning

White Eagle Company

Contractor

FIRST REPORT

SECTION PLAT

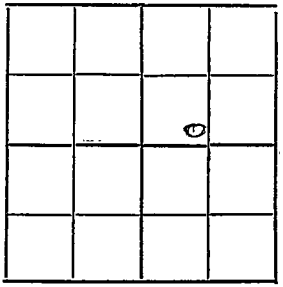

_____Ft. from N. Line

330 Ft. from S. Line

_____Ft. from E. Line

990 Ft. from W. Line

Location _____

Rig up _____

Drilling and Remarks:

RECORD

Cased _____ in., _____ ft.

Sand _____

Gas _____

Oil _____

Total Depth _____

PRODUCTION

1st 24 hrs. Nat. _____

1st 24 hrs. after shot _____

Gas _____ Cu. Ft.

Dry Hole _____

Abandoned _____

Date

APR 6 1925

192____

M. A. BENEAR

Scout

Form 26—1M Bks.—3-23—11959.

Map No. 21 Sec. 19 Twp. 22 R. 10


Well No. 2 Browning

White Eagle Company

Contractor

COMPLETED

SECTION PLAT

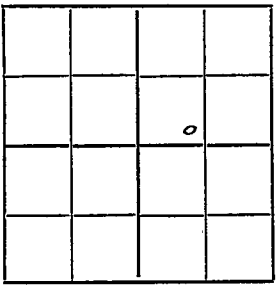

_____Ft. from N. Line

330 Ft. from S. Line

_____Ft. from E. Line

990 Ft. from W. Line

ABANDONED

Location _____

Rig up _____

Drilling and Remarks:

Dry & abd

TD 2405'

RECORD

Cased _____ in., _____ ft.

Sand 2311- 2323 Dry

Gas _____

Oil _____

Total Depth 2405'

PRODUCTION

1st 24 hrs. Nat. _____

1st 24 hrs. after shot _____

Gas _____ Cu. Ft.

Dry Hole /

Abandoned /

Date

JUN 5 1925

192_____

CHAS. L. SHERWOOD

Scout