


Map No. K Sec. 19 Twp. 22 R. 10Well No. 3 Browning FarmA & G Gallagher Company330 Ft. from N. Line

Ft. from S. Line

990 Ft. from E. Line

Ft. from W. Line

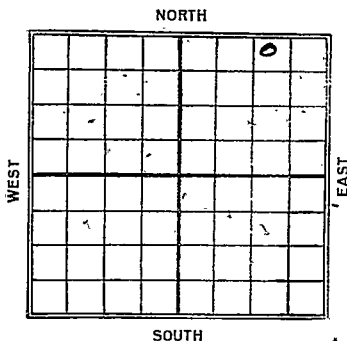

REPORT

Date

5/22 Rwy6/18 Top 2305-19Pay - 2314-47J. 2347Swabbing 150 Blb cat

21 **KANSAS**
 Map No. _____ Sec. 19 Twp. 22 R. 10
 Well No. 3 *Browning*
R. G. Gillespie Company
 _____ Contractor

FIRST REPORT**SECTION PLAT**

330' Ft. from N. Line

_____ Ft. from S. Line

990' Ft. from E. Line

_____ Ft. from W. Line

			0

Location _____

Rig up *✓✓* _____

Drilling and Remarks:

RECORD

Cased _____ in., _____ ft.

Sand _____

Gas _____

Oil _____

Total Depth _____

PRODUCTION

1st 24-hrs. Nat. _____

1st 24 hrs. after shot _____

Gas _____ Cu. Ft.

Dry Hole _____

Abandoned *✓* _____Date
MAY 22 1924

M. A. BENEAR

192

Scout

21 KANSAS
 Map No. _____ Sec. 19 Twp. 22 R. 10

Well No. 3 - *Browning*
P. G. Gillespie Company

Contractor

COMPLETED SECTION PLAT

330 Ft. from N. Line

_____ Ft. from S. Line

990 Ft. from E. Line

_____ Ft. from W. Line

			0

Location _____

Rig up _____

Drilling and Remarks:

Tap 2303-19

Pay 2319-47

T.D. 2347

swapping 150 lbs. Drill

RECORD

Cased _____ in., _____ ft.

Sand _____

Gas _____

Oil _____

Total Depth _____

PRODUCTION

1st 24 hrs. Nat. _____

1st 24 hrs. after shot _____

Gas _____ Cu. Ft.

Day Hole _____

Abandoned _____

Date

JUN 18 1924

192

Scout