


SECTION 19 TOWNSHIP 22 RANGE 10E

WELL NO. #3 Browning

COMPANY E. Adair

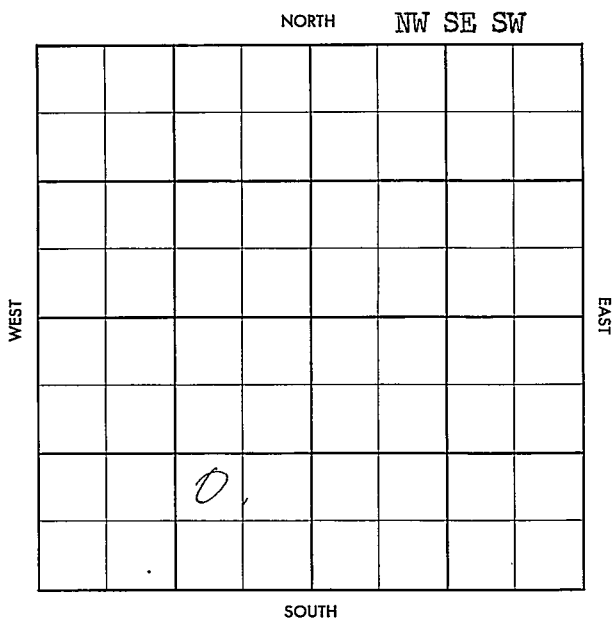

0,


13

County Greenwood Elev. \_\_\_\_\_  
 Sec. 19 Twp. 22 Rge. 10E  
 Company E. Adair  
 Farm Name Browning No. 3

TOPS	DEPTH	LOG	DATUM	Loc. in Sec.
Anh.				NW SE SW
Tr.				
H.				
Tr.				
Dg.				
BL. <u>DIO</u>				
L.				
K.C.				
B.K.C.				
Ce.				
C.				Barnard Tools
M.				
M.				Pool
K.				
Mz.				Browning Pool
Me.				
V.				
S.				
S.				
A.				
R.				
Pe.				
G.				
T.D.				

FIRST REPORT  
 MAR 6 '37

Date Comm. M I R T

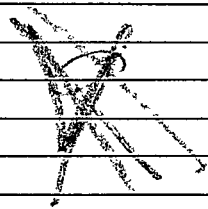

Co.  
 Use  
 No.  
 Sec.  
 T.  
 R.

County Greenwood Elev. 1498 KB  
 Sec. 19 Twp. 22 Rge. 10E  
 Company E. Adair  
 Farm Name Browning No. 3

TOPS	DEPTH	LOG	DATUM	Loc. in Sec.
Anh.				NW SE SW
Tp.				
H.				
Tr.				
Dg.				
Bl.				
L.				Geol.
K.C.	<u>1485</u>			Contr.
B.K.C.				<u>Barnard Tools</u>
Ce.	<u>(part) 2379</u>			<u>Pool</u>
C.				<u>Browning Pool</u>
M.				
M.				
K.				
Mz.				
Mo.				
V.				
S.				
S.				
A.				
R.				
PE.				
G.				
TD.	<u>2416</u>			

**COMPLETE**

APR 17 '57

Date Comm.

M I R T <sup>hole 13 '57</sup> ~~5/2 3-357~~ ~~5/2 2-27-57~~

8" 701 ~~2155~~ MAR 20 '57 MAR 27 '57

5/2 2397 <sup>had</sup> APR 3 '57 <sup>10</sup> 10 APR 10 '57

APR 17 '57 CO 2416 TD \$ 3 60ph

no time FU 125' oil + 25' wt

10 hrs frac flow 50 Bopd no/wt

Pop. P. 25 Bopd no/wt