


Greenwood

Map No. *15* Sec. *19* Twp. *22* R. *10*

Well No. *9-Browning* Farm
Superior Oil Co. Company

NORTH

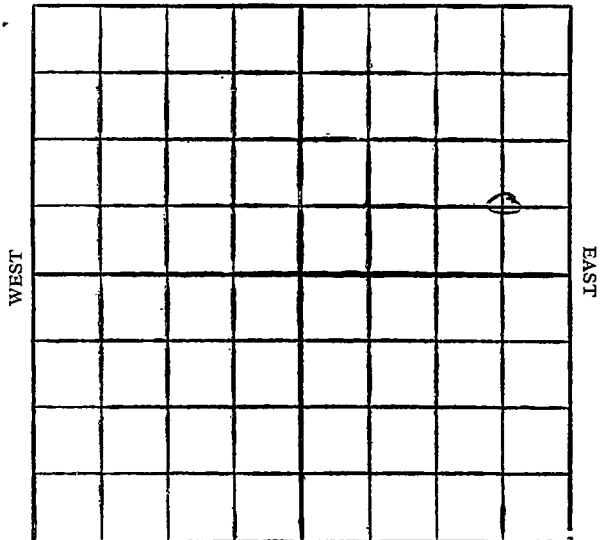

SOUTH

8

Location

Drilling Remarks

.....

.....

Rig Up.....

Drilling Remarks

.....

.....

RECORD

Cased..... in. ft.

Sand

Gas

Oil

Total Depth.....

PRODUCTION

1st 24 hrs. Nat.....

1st 24 hrs. after shot.....

Gas..... cu. ft.

Dry Hole.....

Abandoned.....


Greenwood

Map No. *K5* Sec. *19* Twp. *22* R. *10*

Well No. *9 - Browning* Farm

Superior Oil Company

NORTH

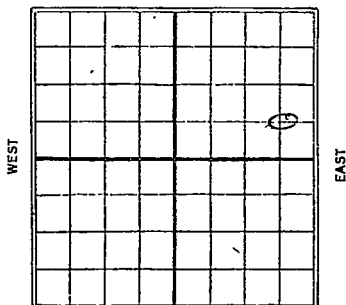

_____ Ft. from N. Line

660 Ft. from S. Line

660 Ft. from E. Line

_____ Ft. from W. Line

1926

Date

REPORT

| Date | REPORT |
|--------------|--|
| <i>12/30</i> | <i>Rig up. (Formally owned By ^{Phillips} <i>Phillips</i>)</i> |
| <i>1927</i> | |
| <i>1/6</i> | <i>Drlg 825</i> |
| <i>1/13</i> | <i>" 1340</i> |
| <i>1/19</i> | <i>" 1675</i> |
| <i>1/26</i> | <i>Top sand 2265 - Will UR.</i> |
| <i>2/3</i> | <i>sand 2273 - 2340 in sd. 600' oil in hole - S.D.</i> |
| <i>2/10</i> | <i>sand 2273 - 2340 20 gts - 75 bbls I.D. 2340'</i> |

Allenwood

21 KANSAS
Map No. _____ Sec. *19* Twp. *22* R. *10*

Well No. *9 Browning*

Superior Oil Co Company

Contractor

FIRST REPORTS

SECTION PLAT

_____ Ft. from N. Line

660 Ft. from S. Line

660 Ft. from E. Line

_____ Ft. from W. Line

| | | | |
|--|--|--|----------|
| | | | |
| | | | <i>0</i> |
| | | | |
| | | | |

Location

Rig up

Drilling and Remarks:

*Formerly owned
By Gillespie*

RECORD

Cased _____ in., _____ ft.

Sand _____

Gas _____

Oil _____

Total Depth _____

PRODUCTION

1st 24 hrs. Nat. _____

1st 24 hrs. after shot _____

Gas _____ Cu. Ft.

Dry Hole _____

Abandoned _____

Date
DEC 30 1926

CHAS. L. SHERWOOD
Scout

Sherwood

21 **KANSAS**
Map No. _____ Sec. *19* Twp. *22* R. *10*

Well No. *9 Drowning*
Superior Oil Co Company

_____ Contractor

COMPLETED

SECTION PLAT

_____ Ft. from N. Line

660 Ft. from S. Line

660 Ft. from E. Line

_____ Ft. from W. Line

| | | | |
|--|--|--|---|
| | | | |
| | | | 0 |
| | | | |
| | | | |

Location _____

Rig up _____

Drilling and Remarks:

209 75 Abs.

RECORD

Cased _____ in _____ ft.

Sand *2273-2340*

Gas _____

Oil _____

Total Depth *2340*

PRODUCTION

1st 24 hrs. Nat. _____

1st 24 hrs. after shot. _____

Gas _____ Cu. Ft.

Dry Hole _____

Abandoned _____

Date

FEB 10 1927

CHAS. L. SHERWOOD

192

Scout