


Map No. Kansas Greenwood Sec. 19 Twp. 22 R. 10
Well No. 37 Browning Farm
Amclair O. & G. Company

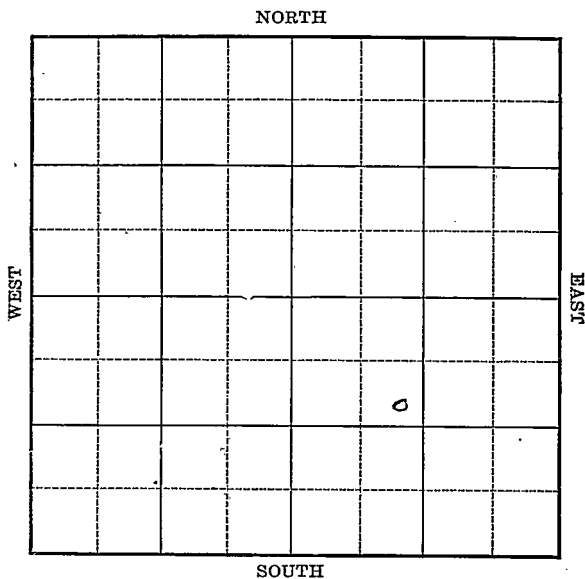

Location _____

Drilling Remarks _____

Rig Up _____

Drilling Remarks _____

RECORD

Cased _____ in. _____ ft.

Sand _____

Gas _____

Oil _____

Total Depth _____

PRODUCTION

1st 24 hrs. Nat. _____

1st 24 hrs. after shot _____

Gas _____ cu. ft.

Dry Hole _____

Abandoned _____

Sherwood Co.

K-21 Map No. **KANSAS** Sec. *19* Twp. *22* R. *10*

Well No. *37* *Drowning*
Pineblain Oil & Gas Co. Company

Contractor

FIRST REPORTS

SECTION PLAT

990 Ft. from N. Line
 ----- Ft. from S. Line
 ----- Ft. from E. Line
990 Ft. from W. Line

| | | | |
|--|--|---|--|
| | | | |
| | | | |
| | | o | |
| | | | |

Location

Rig up -----

Drilling and Remarks:

RECORD

Cased ----- in., ----- ft.
 Sand -----
 Gas -----
 Oil -----
 Total Depth -----

PRODUCTION

1st 24 hrs. Nat. -----
 1st 24 hrs. after shot -----
 Gas ----- Cu. Ft.
 Dry Hole -----
 Abandoned -----

Date

FEB 17 1926

192

CHAS. L. SHERWOOD

Scout

Sherwood

K21
 Map No. **KANSAS** Sec. *19* Twp. *22* R. *10*

Well No. *37 Downing*
McClain Oil Co Company

Contractor

COMPLETED

SECTION PLAT

990 Ft. from N. Line

_____ Ft. from S. Line

_____ Ft. from E. Line

990 Ft. from W. Line

| | | | |
|--|--|--|--|
| | | | |
| | | | |
| | | | |
| | | | |

Location _____

Rig up _____

Drilling and Remarks:

20,150 lbs.

RECORD

Cased _____ in., _____ ft.

Sand *2295-2355'*

Gas _____

Oil _____

Total Depth *2355*

PRODUCTION

1st 24 hrs. Nat. _____

1st 24 hrs. after shot _____

Gas _____ Cu. Ft.

Dry Hole _____

Abandoned _____

Date

APR 28 1926

CHAS. L. SHERWOOD
 Scout