
Form 51—5M—10-26—Mid-West

Kansas

Map No. ..... Sec. 19 Twp. 22 R. 10

Well No. 52 - Browning Farm

Sinclair Company

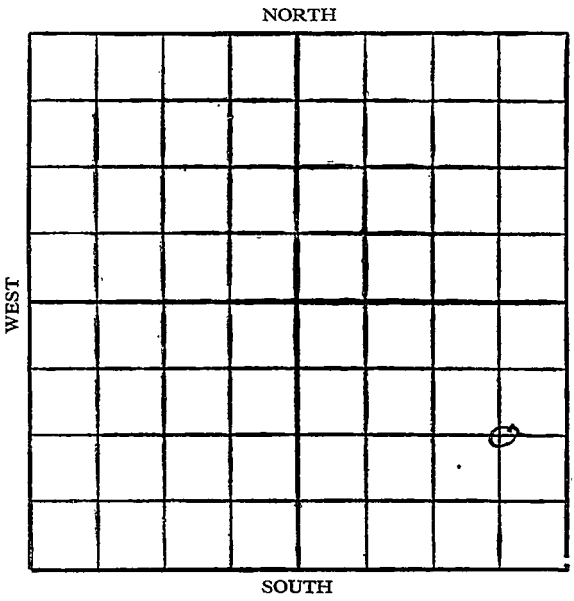

9-


Location	Rig Up .....
Drilling Remarks	Drilling Remarks
.....	.....
.....	.....
RECORD	PRODUCTION
Cased ..... in. ..... ft.	1st 24 hrs. Nat. .....
Sand	1st 24 hrs. after shot .....
Gas	Gas ..... cu. ft.
Oil	Dry Hole .....
Total Depth	Abandoned .....

Form 252A—5M—10-26—24951 Greenwood

Map No. K5 Sec. 19 Twp. 22 R. 10

Well No. 52 - Browning Farm

Sinclair Company

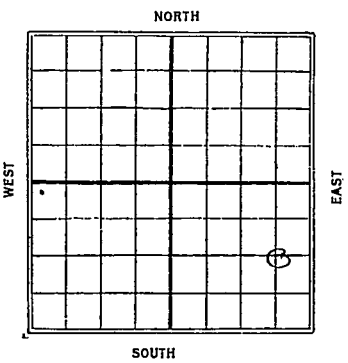

____ Ft. from N. Line

1320 Ft. from S. Line

660 Ft. from E. Line

____ Ft. from W. Line

1927

Date	REPORT
2/3	Bldg Rig
2/10	Rigging Up
2/17	Drlg 325
2/24	" 1175
3/2	" 1475
3/9	" 2050
3/16	Sand 2297-2372 20 gts. 125 Mcfs.

Form 26—1M Bks.—3-23—11959. Bleenwood

21 KANSAS

Map No._____ Sec. 19 Twp. 22 R. 10

Well No. 52 Browning

Sinclair Company

_____ Contractor

FIRST REPORTS


_____Ft. from N. Line

1320 Ft. from S. Line

660 Ft. from E. Line

_____Ft. from W. Line

SECTION PLAT

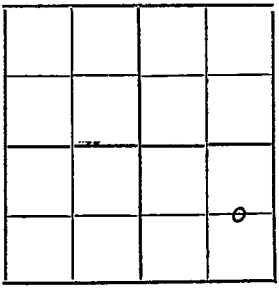

Location _____

Rig up Bldg Rig

Drilling and Remarks:

RECORD

Cased_____in., _____ ft.

Sand _____

Gas _____

Oil _____

Total Depth _____

PRODUCTION

1st 24 hrs. Nat. _____

1st 24 hrs. after shot _____

Gas _____ Cu. Ft.

Dry Hole _____

Abandoned _____

Date

DEC 3 1927

_____192____

CHAS. L. SHERWOOD

_____Scout

Form 26—1M Bks.—3-23—11959. Sherwood

21 KANSAS

Map No. _____ Sec. 19 Twp. 22 R. 10

Well No. 52 Browning

Sinclair Oil

_____ Company

_____ Contractor

COMPLETED


1320 Ft. from N. Line

_____ Ft. from S. Line

660 Ft. from E. Line

_____ Ft. from W. Line

SECTION PLAT

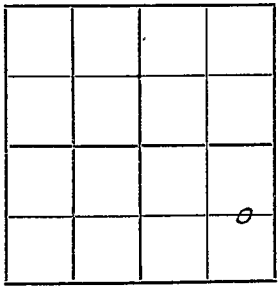

Location _____

Rig up _____

Drilling and Remarks:

20/125 lbs.

RECORD

Cased _____ in., _____ ft.

Sand 2297-2372

Gas _____

Oil _____

Total Depth 2372

PRODUCTION

1st 24 hrs. Nat. _____

1st 24 hrs. after shot _____

Gas _____ Cu. Ft.

Dry Hole _____

Abandoned _____

Date

MAR 16 1937

_____ 192___

CHAS. L. SHERWOOD

_____ Scout