


Greenwood

KANSAS

SECTION 19 TOWNSHIP 22S RANGE 10E

WELL NO. #3 Browning "B"

COMPANY E.H. Adair

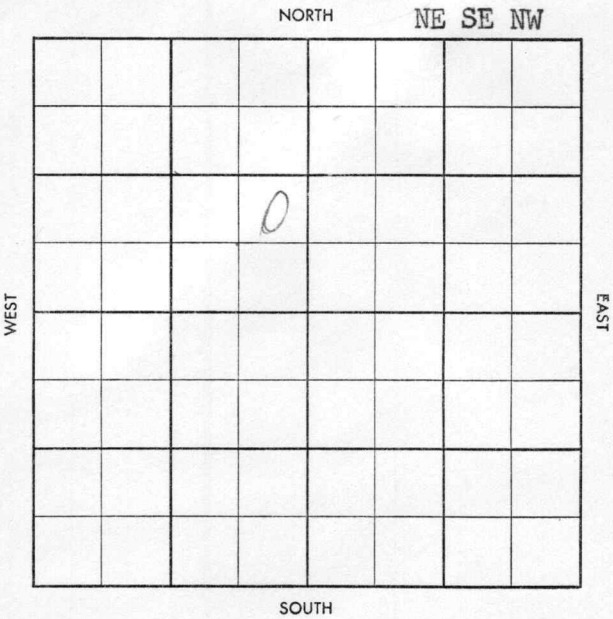

6



Eureka H&C Dr/ls



Phone 125

Wichita
Browning

S-513-A

CO. Greenwood ELEV 1500 ft
SEC. 19 TWP. 22 RGE. 10E
COMPANY E. H. Adair NO. 3

JAN 15 '58
ABANDONED

FARM Browning "B"

LOC. NE SW NW

<u>Cattleman's 2372</u>	
<u>Bont Zone 2390</u>	
<u>TD</u>	<u>2450</u>

GEOL. _____
CONTR. 1 & C Tools
POOL Denslorie-Sowder
SPUD 1-3-58
Location JAN 2
JAN 15 '58 8 5/8 200
Ø 1291 JAN 15 '58
no tests
NO log Crd
2374 - 2414

full rec
NO log

no tests

D&A

CO.
LSE.
NO.
SEC.
TWP.
RGE.