


Map No. Kansas Sec. 19 Twp. 22 R. 10

Well No. 43 Browning Farm

Sinclair O. & G. Company

NORTH

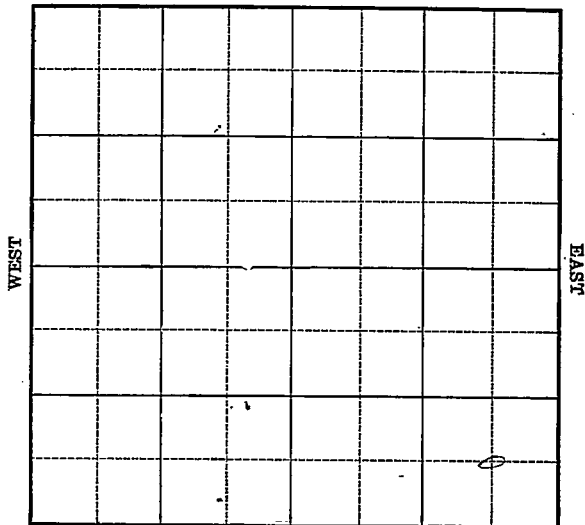

SOUTH

16.

Location _____

Drilling Remarks _____

Rig Up _____

Drilling Remarks _____

RECORD

Cased _____ in. _____ ft.

Sand _____

Gas _____

Oil _____

Total Depth _____

PRODUCTION

1st 24 hrs. Nat. _____

1st 24 hrs. after shot _____


Gas _____ cu. ft.

Dry Hole _____

Abandoned _____

Map No. *Kans.* Sec. *19* Twp. *22* R. *10*
 Well No. # *43* *13 Browning* Farm
Sinclair Oil Gas Company

..... Ft. from N. Line
660 Ft. from S. Line
660 Ft. from E. Line
 Ft. from W. Line

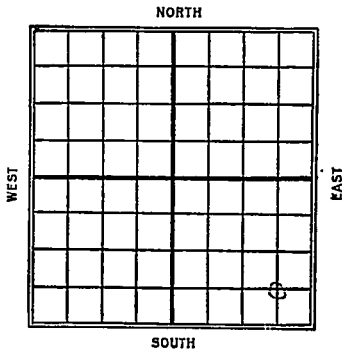

1926.

Date	REPORT
<i>5/19</i>	<i>Location</i>
<i>6/2</i>	<i>Same</i>
<i>6/10</i>	_____
<i>6/18</i>	<i>Bldg rig</i>
<i>6/25</i>	<i>Spudding</i>
<i>6-30</i>	<i>Drly 925</i>
<i>7/8</i>	<i>" 1280</i>
<i>7/15</i>	<i>St. reaming T.D. 1280</i>
<i>7/22</i>	<i>S.D. 1280.</i>
<i>7/28</i>	<i>same</i>
<i>8/4</i>	_____
<i>8/11</i>	_____
<i>8/18</i>	<i>running 10" 1300</i>
<i>8/25</i>	<i>Drly 1940</i>
<i>8-31</i>	<i>Sand 2335-2425 1000 oil</i> <i>in Rob. drly 2425</i>
<i>9/16</i>	<i>Sand 2335-2425</i> <i>60/120 Blbs</i>

Sherwood

K21 KANSAS Map No. Sec. 19 Twp. 22 R. 10

Well No. 43 *Browning*
McClain and Co Company

Contractor

FIRST REPORTS

SECTION PLAT

----- Ft. from N. Line
660 Ft. from S. Line
660 Ft. from E. Line
 ----- Ft. from W. Line

			o

Location -----
 Rig up -----
 Drilling and Remarks:

RECORD

Cased ----- in., ----- ft.
 Sand -----
 Gas -----
 Oil -----
 Total Depth -----

PRODUCTION

1st 24 hrs. Nat. -----
 1st 24 hrs. after shot -----
 Gas ----- Cu. Ft.
 Dry Hole -----
 Abandoned -----

Date

MAY 19 1926

CHAS. L. SHERWOOD
 Scout

KANSAS

Steerwood

Map No. 21 Sec. 19 Twp. 22 R. 10

Well No. 43 Blount Co.

Sanclair Oil & Co. Company

Contractor

SECTION PLAT

COMPLETED

_____ Ft. from N. Line

660

_____ Ft. from S. Line

660

_____ Ft. from E. Line

_____ Ft. from W. Line

			o

Location _____

Rig up _____

Drilling and Remarks:

660 / 120 Bl

RECORD

Cased _____ in., _____ ft.

Sand 7335-2425

Gas _____

Oil _____

Total Depth 2425

PRODUCTION

1st 24 hrs. Nat. _____

1st 24 hrs. after shot. _____

Gas _____ Cu. Ft.

Dry Hole _____

Abandoned _____

Date

SEP 15 1926

CHAS. L. SHERWOOD

Scout