



Kansas

Map No. \_\_\_\_\_ Sec. 19 Twp. 22 R. 10


Well No. 54-Browning Farm  
Sinclair Company

1320 Ft. from N. Line

\_\_\_\_\_ Ft. from S. Line

50 Ft. from E. Line

\_\_\_\_\_ Ft. from W. Line

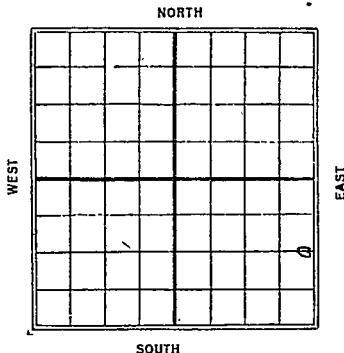

1927

Date	REPORT
2/3	Location
2/10	Bldg rig
2/17	Rig
2/24	—
3/2	—
3/9	—
3/16	—
3/24	Rigging up
3/30	Spudding
4/7	Drlg 350
4/13	" 1400
4/20	" 1815
4/27	" 2110
5/5	Sand 2277-2353 60 gts / 110 bbls F.D. 2353'

*Sherwood*

21 KANSAS

Map No. \_\_\_\_\_ Sec. *19* Twp. *22* R. *10*

Well No. *54 Browning*

*Sinclair* Company

Contractor

FIRST REPORTS

SECTION PLAT

*1320* Ft. from N. Line

\_\_\_\_\_ Ft. from S. Line

*50* Ft. from E. Line

\_\_\_\_\_ Ft. from W. Line


Location

Rig up \_\_\_\_\_

Drilling and Remarks:

RECORD

Cased \_\_\_\_\_ in., \_\_\_\_\_ ft.

Sand \_\_\_\_\_

Gas \_\_\_\_\_

Oil \_\_\_\_\_

Total Depth \_\_\_\_\_

PRODUCTION

1st 24 hrs. Nat. \_\_\_\_\_

1st 24 hrs. after shot \_\_\_\_\_

Gas \_\_\_\_\_ Cu. Ft.

Dry Hole \_\_\_\_\_

Abandoned \_\_\_\_\_

Date  
DEC 3 1927

CHAS. L. SHERWOOD  
Scout

*Shirwood*  
 21 KANSAS  
 Map No. \_\_\_\_\_ Sec. *19* Twp. *22* R. *10*  
 Well No. *54 Browning*  
*Shelton Oil Co* Company

Contractor

**COMPLETE**

**SECTION PLAT**

*1320* Ft. from N. Line

\_\_\_\_\_ Ft. from S. Line

*50* Ft. from E. Line

\_\_\_\_\_ Ft. from W. Line

			⊙

Location \_\_\_\_\_

Rig up \_\_\_\_\_

Drilling and Remarks:

*60/110 lbs.*

**RECORD**

Cased \_\_\_\_\_ in., \_\_\_\_\_ ft.

Sand *2277-2353*

Gas \_\_\_\_\_

Oil \_\_\_\_\_

Total Depth *2353*

**PRODUCTION**

1st 24 hrs. Nat. \_\_\_\_\_

1st 24 hrs. after shot \_\_\_\_\_

Gas \_\_\_\_\_ Cu. Ft.

Dry Hole \_\_\_\_\_

Abandoned \_\_\_\_\_

Date

MAY 5 1927

CHAS. L. SHERWOOD

192

Scout