

KANSAS

Greenwood


Form 51-5M-7-39-Palace

Section 19 Township 22 Range 10-E

Well No. #61 Browning

Company Sinclair Prairie

NORTH Browning Pool

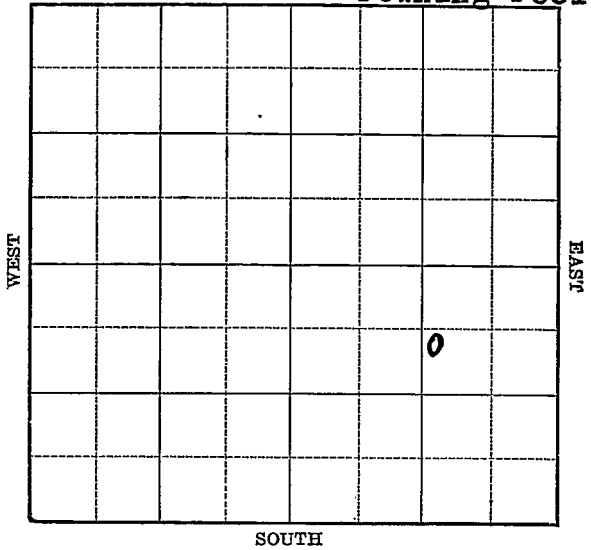

9

Sec. 19 Twp. 22 R. 10-E

Well No. #61 Browning Farm

Sinclair-Prairie Company


(Browning)

720 Ft. from N. Line

_____ Ft. from S. Line

1055 Ft. from E. Line

_____ Ft. from W. Line

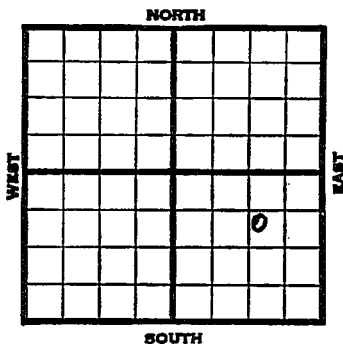

1940.	REPORT
1/31	Location
2/8	"
2/15	Machine.
2/23	Rigging up.
2/29	Spud 65'
3/8	15" - 80' 12" - 381'
	Drlg. 410'
3/14	Drlg. 1095'
3/21	1415' run 10".
3/28	10" - 1419' Drlg. 1975'
4/4	Bart. 2259' 7" - 2259' T.D. WOC
5/12	Shot 80 qts. C. O.
4/17	Bart. 2298'
	7" - 2259'
	T.D. 2325'
	Shot 80 qts.
	Pump 10 bbls.
	COMPLETED

Map No. 21 Sec. 19 Twp. 22 R. 10E

Well No. 61 Browning

Sinclair Prairie Company

Contractor

FIRST REPORT

SECTION PLAT

C W L N E S E

720 Ft. from N. Line

_____ Ft. from S. Line

1055 Ft. from E. Line

_____ Ft. from W. Line

BROWNING POOL

			0

Location X

Rig up _____

Drilling and Remarks:

RECORD

Cased _____ in., _____ ft.

Sand _____

Gas _____

Oil _____

Total Depth _____

PRODUCTION

1st 24 hrs. Nat. _____

1st 24 hrs. after shot _____

Gas _____ Cu. Ft.

Dry Hole _____

Abandoned _____

Date

JAN 31 1940

19

S. J. LEWIS

Scout

Map No. 21 Sec. 19 Twp. 22 R. 10E

Well No. 61 Browning

Sinclair Prairie Company

Contractor

COMPLETED

C W L N E S E

720 Ft. from N. Line

_____ Ft. from S. Line

1055 Ft. from E. Line

_____ Ft. from W. Line

BROWNING POOL

SECTION PLAT

			o

Location _____

Rig up _____

Drilling and Remarks:

Bar # 2298
7" C 2259.
Shot # 809 to.
Pump 10 Hk.

RECORD

Cased _____ in., _____ ft.

Sand _____

Gas _____

Oil _____

Total Depth 2325

PRODUCTION

1st 24 hrs. Nat. _____

1st 24 hrs. after shot _____

Gas _____ Cu. Ft.

Dry Hole _____

Abandoned _____

Date

APR 17 1940 19

S. J. LEWIS Scout