

HOT FILE		Greenwood	KANSAS
SEC.	TWP.	R.	
19	22 S	10 E	
(Browning Unit WtrFld)			
# 15-W Browning Unit "B"			FARM
COMPANY		CONTRACTOR	
Sinclair		(DEVELOPMENT*OB0C	

Browning Field

10' _____ FT. FROM N. LINE


_____ FT. FROM S. LINE

660' _____ FT. FROM E. LINE

_____ FT. FROM W. LINE

of NE/4

N/2 N/2 NE NE

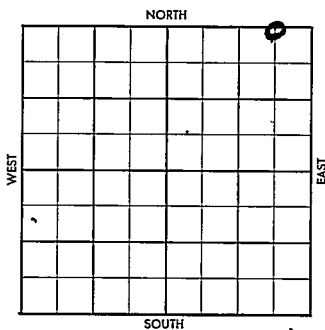

	ELEVATION	REPORT
1957		
	2500'	Bartlesville Test <u>No FR</u>
2/19	Drlg. 2120'	(DR#35-1957)
2/20	TD 2386'	Prep to EL
2/21	MX TD 2386'	WOC - 5 1/2" @ 2324'
2/22	Spudded 2-8-57	
	TD 2386'	WOC - 5 1/2" csg.
2/25	TD 2386'	WOC - 5 1/2" csg.
2/26	TD 2386'	Fishing.
2/27	TD 2386'	NR-
2/28	TD 2386'	Prep to run tbg.
3/1	TD 2386'	Ran tbg.
3/4	TD 2386'	Water Injection Well
	Open hole 2324-2386'	Bartlesville
	Zone. Complete	(DR#44-1957)

COMPLETED