

WELL NO.

Sinclair

(DEVELOPMENT-OB0C)

Browning Field.

990 _____ FT. FROM N. LINE


_____ FT. FROM S. LINE

990 FT. FROM E. LINE

_____ 0 _____ FT. FROM W. LINE

of NE/4

SW NE NE

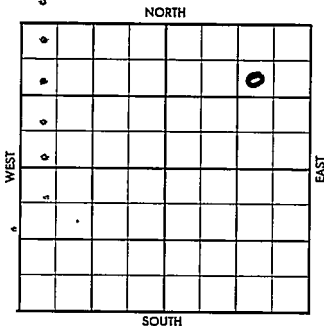

1

ELEVATION

REPORT

1956

2500' Bartlesville Test

No FR

9/18 Drlg. 1215'

(DR#182)

9/19	Spudded 9-11-56
------	-----------------

Dr1g. 1749'

9/20	Dr1g. 2130'
------	-------------

9/21	TD 2376'. Prep to run csg.
------	----------------------------

9/24 TD 2376'. WOC - 5 $\frac{1}{2}$ " csg @ 2275'

9/25 TD 2376'. WOC - $5\frac{1}{2}$ " csg.

9/26 TD 2376'. WOC - $5\frac{1}{2}$ " csg.

9/27	TD 2376	"	"
------	---------	---	---

9/28 TD 2376'. WOC - $5\frac{1}{2}$ " csg.

10/1	TD 2376'. WOC - 5 $\frac{1}{2}$ " csg.
------	--

10/2	"	"	"
------	---	---	---

10/3	11	11	11
------	----	----	----

10/4.	"	"	"
-------	---	---	---

10/5	TD 23761.	11	11
------	-----------	----	----

10/8	TD 2376'.	"	"
------	-----------	---	---

10/9	TD 23761.	"	"
------	-----------	---	---

10/10	TD 2376	"	"
-------	---------	---	---

10/11	"	"	"
-------	---	---	---

10/12	TD 2376	"	"
-------	---------	---	---

70/15	"	"	"
-------	---	---	---

10/15	"	"	"
10/16	"	"	"

10/10 OVER

OVER

1956
 10/17 TD 2376'. WOC - 5 $\frac{1}{2}$ " csg.
 10/18 " 2 "
 10/19 TD 2376'. " "
 10/22 TD 2376'. " "
 10/23 TD 2376'. " "
 10/24 TD 2376'. " "
 10/25 MTD 2376'. MICT
 10/26 TD 2376'. Drlg. plug.
 10/29 TD 2376'. "
 10/30 TD 2376'. Testing open hole 2275-2376'
 10/31 TD 2376'. No oil test. Open hole
 2275-2376'. Bartlesville Zone.
 Complete (DR#213)

COMPLETED