


HOT FILE

Greenwood Co. KANSAS

SEC.	TWP.	R.
19	22 S	10 E
WELL NO. (Browning Unit Waterflood)		
# 69 Browning Unit		FARM
COMPANY		
Sinclair O & G (Development-OBOG)		
CONTRACTOR		

_____ Ft. from N. Line
 660 _____ Ft. from S. Line
 1230 _____ Ft. from E. Line
 _____ Ft. from W. Line

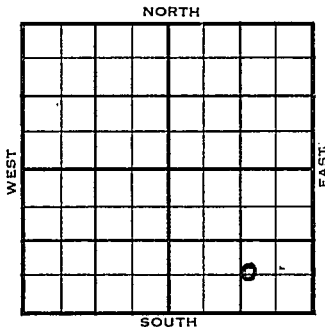

of SE/4
 W/2 SE SE

ELEVATION	REPORT
1955	<u>No F.R.</u>
10/19	Spud 9-21-55 Drlg. 1825' (DR #205)
10/20	Drlg. 2260'
10/21	TD 2353'. Coring.
10/24	TD 2429'. Rng csg.
10/25	TD 2429'. WOC - 5 1/2" csg @2332'
10/26	TD 2429'. Drlg. cement.
10/27	TD 2429'. No report.
10/28	TD 2429'. Open hole 2332-2429' Bartlesville Zone - Water injection well.
ABANDONED	