

SEC. 19 TWP. 22 S R. 10 E

WELL NO. (Browning Wtr. Flood)

90-W Browning Unit Tr. "A" FARM

COMPANY Sinclair (DEVELOPMENT-OBOC)

CONTRACTOR


Browning Field.

5' _____ FT. FROM N. LINE

_____ FT. FROM S. LINE

_____ FT. FROM E. LINE

5' _____ FT. FROM W. LINE

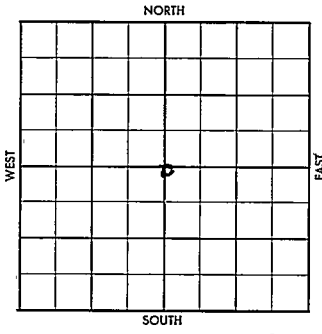

of SE/4
NW NW NW SE

10

	ELEVATION	REPORT
1958	2425'	B'ville Test <u>No FR</u>
2/20	Spudded 2-15-58	(DR#36)
	Drlg. 440'	
2/21	Drlg. 1426'	
2/24	Drlg. 1789'	
2/25	TD 2383'. WOC. 5 1/2" @ 2334'	
2/26	TD 2383'. WOC. 5 1/2" csg.	
2/27	TD 2383'. WOC. 5 1/2" csg.	
2/28	TD 2383'. WOC. 5 1/2" csg.	
3/3	TD 2383'. WOC. 5 1/2" csg.	
3/4	" " "	
3/5	TD 2383'. Drlg. plug.	
3/6	TD 2383'. Drlg. plug.	
3/7	" "	
3/10	TD 2383'. Prep to test.	
3/11	TD 2383'. NR	
3/12	" "	
3/13	" "	
3/14	TD 2383'. Water Injection Well.	
	Open hole 2334-83' B'ville Zone.	
	Complete (DR#52)	

COMPLETED