


SEC. 19 TWP. 22 S R. 10 E
 WELL NO. (Browning Unit Wtr # 80-W Browning Unit Tr. "A" Fld) FARM

COMPANY Sinclair (DEVELOPMENT_OBOC)

CONTRACTOR
 Browning Field.

_____ FT. FROM N. LINE
 660 _____ FT. FROM S. LINE
 1980 _____ FT. FROM E. LINE
 _____ FT. FROM W. LINE
 of SE/4
 C SW SE

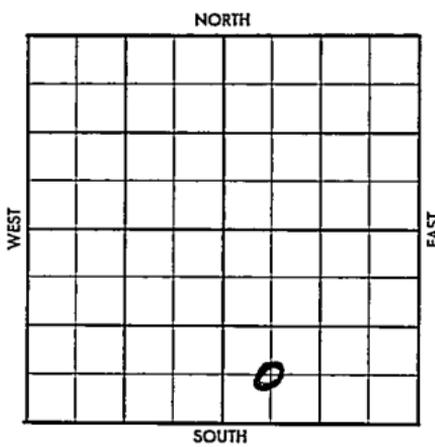

1956	ELEVATION REPORT
10/4	2900' Bartlesville Test Spudded 10-3-56 Drlg. 40' <u>No FRJ</u> (DR#194)
10/5	TD 40'. NR
10/8	Drlg. 775'
10/9	Drlg. 2140'
10/10	TD 2344'. Coring.
10/11	TD 2406'. Rng. csg.
10/12	TD 2406'. WOC - 5 1/2" @ 2332'
10/15	TD 2406'. WOC - 5 1/2" csg.
10/16	TD 2406'. WOC - 5 1/2" csg.
10/17	" " "
10/18	TD 2406' " "
10/19	TD 2406' " "
10/22	TD 2406' " "
10/23	TD 2406'. Drlg. plug.
10/24	TD 2406'. "
10/25	TD 2406'. Cleaning out.
10/26	TD 2406'. Water Injection Well Open hole 2332-2406' Bartlesville Zone. Complete (DR#210)

COMPLETED