

SEC. 19 TWP. 22 S R. 10 E
 WELL NO. (Browning Unit Wtr. Flood)
 # 83 Browning Unit Tr. "A" FARM

COMPANY
 Sinclair (DEVELOPMENT-OBOC)

CONTRACTOR

Browning Field

_____ FT. FROM N. LINE


990 _____ FT. FROM S. LINE

_____ FT. FROM E. LINE

330 _____ FT. FROM W. LINE

of SE/4

NW SW SE

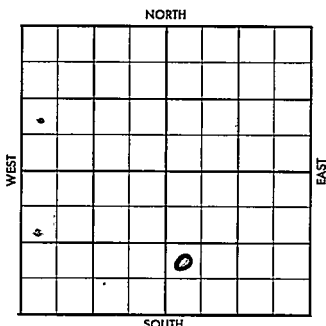

ELEVATION

1957

REPORT

2500' Bartlesville Test

No FR

3/27

Spudded 3-24-57
 Drlg. 2381'

(DR#61-1957)

3/28

TD 2415'. WOC. 5 1/2" @ 2364'

3/29

TD 2415'. WOC. 5 1/2" csg.

4/1

TD 2415' MICT

4/2

" "

4/3

TD 2415'. Bailing.

4/4

TD 2415'. Drlg. plug.

4/5

TD 2415'. Prep to frac.

4/8

TD 2415'. Swabbing load oil
 Open hole 2364-2415'

4/9

TD 2415'. Swabbing load oil.

4/10

TD 2415' Swabbing load oil.

4/11

TD 2415'. Instl. Pumping Unit.

4-12

TD 2415'. Inst. pumping unit - Open
 hole 2364-2415'.

4-15

" " " "

4-16

" " " "

4-17

" " " "

4/18

" " " "

4/22

" " " "

4/23

" " " "

OVER

1957

4/24 TD 2415'. Inst. Pumping Unit.
Open hole 2364-2415'

4/25 TD 2415' " "

4/26 TD 2415' " "

4/29 TD 2415'. " "

4/30 " " "

5/1 TD 2415' " "

5/2 " " "

5/3 TD 2415' " "

5/6 TD 2415'. Pumping on test.
Open hole 2364-2415'

5/7 " " "

5/8 TD 2415'. No oil Test.

Open hole 2364-2415'

Bartlesville Zone.

Complete

(DR#90-1957)

COMPLETED