

# HOT FILE Greenwood KANSAS

SEC. 19	TWP. 22 S	R. 10 E
WELL NO. (Browning Water Flood)		
# 89-W Browning Unit Tr. "A" <span style="float:right">FARM</span>		
COMPANY Sinclair (DEVELOPMENT-OBOC)		
CONTRACTOR		


## Browning Field.

5' \_\_\_\_\_ FT. FROM N. LINE

\_\_\_\_\_ FT. FROM S. LINE

\* \_\_\_\_\_ FT. FROM E. LINE

1320' \_\_\_\_\_ FT. FROM W. LINE

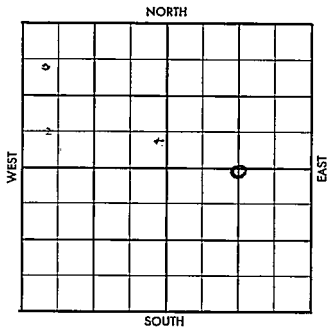

of SE/4  
N/2 N/2 N/2 SE/4

1958	ELEVATION	REPORT
	2425'	Bartlesville Test <u>NOFR</u>
2/25	Spudded 2-21-58	
	Drlg. 176'	(DR#39)
2/26	TD 176'. NR	
2/27	TD 202'. Prep to run csg.	
2/28	TD 202'. WOC. 8-5/8" @ 201'	
3/3	TD 202'. WOC. 8-5/8" csg.	
3/4	TD 202'. WOC. "	
3/5	" " "	
3/6	TD 202'. WOC. 8-5/8" csg.	
3/7	TD 202'. WOC. 8-5/8" csg.	
3/10	Drlg. 1515'	
3/11	TD 1515'. NR	
3/12	" "	
3/13	" "	
3/14	TD 2361'. WOCT. 5 1/2" @ 2278'	
3/17	TD 2361' WOCT	
3/18	TD 2361' NR	
3/19	TD 2361'. WOCT	
3/20	TD 2361'. NR	
3/21	TD 2361'. WOCT	
3/24	TD 2361'. WOCT	

**OVER**

1958  
 3/25 TD 2361' WOCT  
 3/26 TD 2361' "  
 3/27 TD 2361' NR  
 3/28 TD 2361' WOCT  
 3/31 " "  
 4/1 TD 2361' NR  
 4/2 TD 2361' WOCT  
 4/3 TD 2361' NR  
 4/7 TD 2361' . WOCT  
 4/8 TD 2361' NR  
 4/9 TD 2361' . Cleaning out.  
 4/10 " "  
 4/11 TD 2361' NR  
 4/14 TD 2361' Water Injection Well  
 Open hole 2278-2361' B'ville Zone.  
 Complete (Producing-Oil Well Temp.)  
**COMPLETED** (DR#72)