

Section 19 Township 22 Range 11 EWell No. # 6 Greenwood UnitCompany Cities Service Oil

NORTH

WEST

			0				

EAST

SOUTH

11

Greenwood KANSAS

Sec. 19 Twp. 22 R. 11E

Well No. #6 Greenwood Unit Farm

Cities Service Oil Company

Contractor


330 Ft. from N. Line

Ft. from S. Line

330 Ft. from E. Line

Ft. from W. Line

NE NE SW

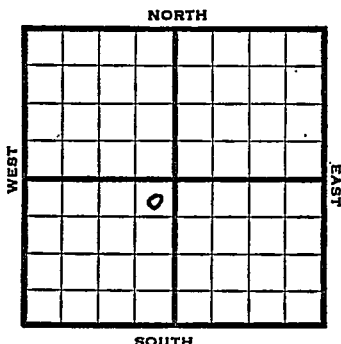

1953 Elev. 1391' RBREPORT

5/20 Oil Well
TD 2091
Bart 2046-91
5" @ 2045
TD 2091
PB 2078
30qt/2057-78
P/1½ bo 1 hr.
Waiting on Water Flood
Comp.

FIRST REPORT

COMPLETED

County Greenwood State Kansas

Sec. 19 (Blk. Twp.) 22 (Sur. Rge.) 11E Map No.

Operator Cities Service Oil

Well No. 6 Farm Greenwood Unit

Elev. 1391 RR Location NE NE SE

FIRST REPORT
O ✓
COMPLETE

320 Ft. From N Line SW

330 Ft. From T. Line Quarter

1st. Report **MAY 20 1953**

Completion **MAY 20 1953**

Remarks 4

Spudding Date _____

Drlg. Data Oil Well TD 2001

Part. 2046-97 , 5" @ 2045 TD 2091

PR 2078 30 pt/ 2057-78 P/ 1½ bo 1 hr.

~~waiting on water flood Comp.~~