


*Greenwood*

Form 51-5M-2-29-34703

Map No. **KANSAS** Sec. *19* Twp. *22* R. *11<sup>E</sup>* ✓

Well No. *1 - Harris* Farm  
*Bladder Pet* Company

NORTH

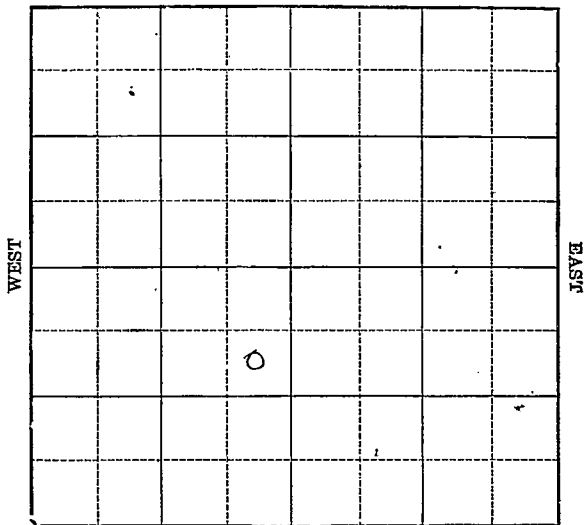

SOUTH

*11*

Location \_\_\_\_\_  
Drilling Remarks \_\_\_\_\_

Rig Up \_\_\_\_\_  
Drilling Remarks \_\_\_\_\_

**RECORD**


Cased \_\_\_\_\_ in. \_\_\_\_\_ ft.  
Sand \_\_\_\_\_  
Gas \_\_\_\_\_  
Oil \_\_\_\_\_  
Total Depth \_\_\_\_\_

**PRODUCTION**

1st 24 hrs. Nat. \_\_\_\_\_  
1st 24 hrs. after shot \_\_\_\_\_  
Gas \_\_\_\_\_ cu. ft. \_\_\_\_\_  
Dry Hole \_\_\_\_\_  
Abandoned \_\_\_\_\_

Map No. KANSAS Sec. 19 Twp. 22 R. 11<sup>E</sup>  
Well No. 1- Harris Farm  
Aladdin Pet Company

990 Ft. from N. Line  
\_\_\_\_\_ Ft. from S. Line  
330 Ft. from E. Line  
\_\_\_\_\_ Ft. from W. Line  
1930

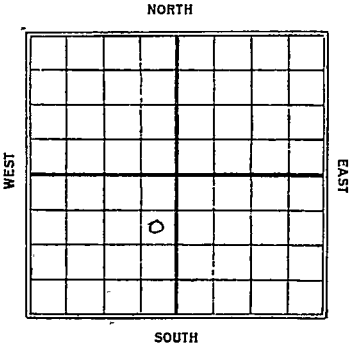

Date	REPORT
5/28	Loc
6/4	
6/11	Spdy.
6/18	
6/25	hrlg. 500'
7/2	" 1260'
7/9	8" collapsed 1630'
7/16	hrlg. 1765'
7/23	Sand 2025-71'
	TD 2071
	shot 160 qt
	@ 410 bbl oil
	Comp.

*Greenwood*

21 Map No. **KANSAS** Sec. 19 Twp. 22 R. 11 <sup>E</sup>

Well No. 1 *Harris*

*Aladdin* *Pat Co* Company

Contractor

**FIRST REPORTS**

990 Ft. from N. Line

\_\_\_\_\_ Ft. from S. Line

330 Ft. from E. Line

\_\_\_\_\_ Ft. from W. Line

**SECTION PLAT**

	0		

Location

Rig up \_\_\_\_\_

Drilling and Remarks:

**RECORD**

Cased \_\_\_\_\_ in., \_\_\_\_\_ ft.

Sand \_\_\_\_\_

Gas \_\_\_\_\_

Oil \_\_\_\_\_

Total Depth \_\_\_\_\_

**PRODUCTION**

1st 24 hrs. Nat. \_\_\_\_\_

1st 24 hrs. after shot \_\_\_\_\_

Gas \_\_\_\_\_ Cu. Ft.

Dry Hole \_\_\_\_\_

Abandoned \_\_\_\_\_

Date

MAY 28 1930

**CHAS. L. SHERWOOD**

Scout

MAY 28 1930

Map No. KANSAS Sec. 19 Twp. 22 R. 11

Well No. 1 Harris

Aladdin Gas Co Company  
Contractor

**COMPLETE**

990 Ft. from N. Line  
\_\_\_\_\_ Ft. from S. Line  
330 Ft. from E. Line  
\_\_\_\_\_ Ft. from W. Line

**SECTION PLAT**


Location \_\_\_\_\_

Rig up \_\_\_\_\_

Drilling and Remarks: \_\_\_\_\_

160/410 Bl.

**RECORD**

Cased \_\_\_\_\_ in. \_\_\_\_\_ ft.  
Sand 2075-2071  
Gas \_\_\_\_\_  
Oil \_\_\_\_\_  
Total Depth 2071

**PRODUCTION**

1st 24 hrs. Nat. \_\_\_\_\_  
1st 24 hrs. after shot \_\_\_\_\_  
Gas \_\_\_\_\_ Cu. Ft.  
Dry Hole \_\_\_\_\_  
Abandoned \_\_\_\_\_

Date  
JUL 23 1930

**CHAS. L. SHERWOOD**  
Scout