


Greenwood, KANSAS

SECTION 19 TOWNSHIP 22 RANGE 11E

WELL NO. #1 Harris

COMPANY Pat Murphy

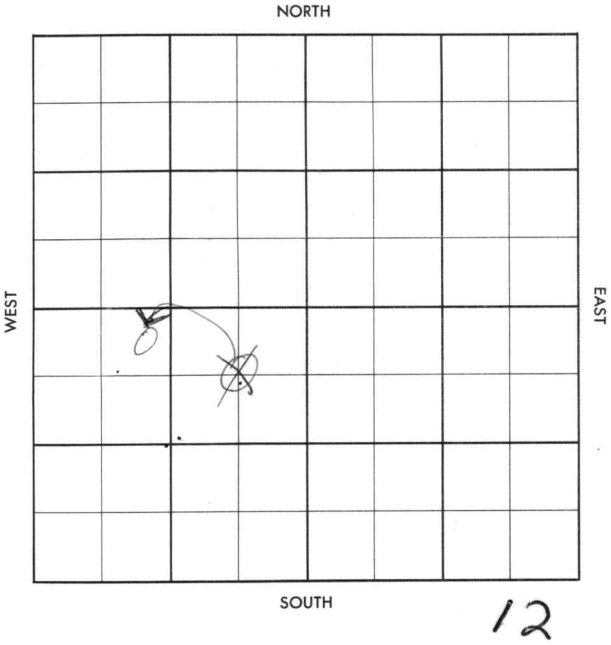

# HOT FILE Greenwood KANSAS

SEC. 19 TWP. 22 S R. 11 E

WELL NO. # 1 Harris

COMPANY Pat Murphy

CONTRACTOR Jackman & Jackman


DeMalorie-Sowder Pool

330 FT. FROM N. LINE

FT. FROM S. LINE

1650 FT. FROM E. LINE

FT. FROM W. LINE

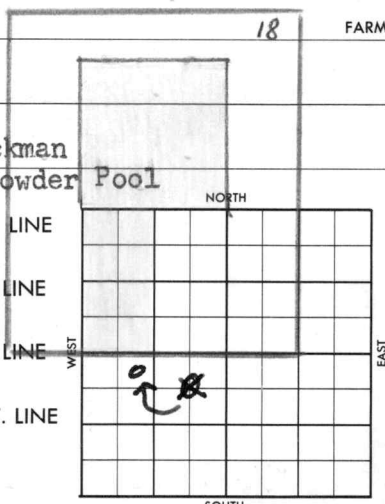

~~NE NEWSW~~  
~~G NE SW~~

SDX - DHC -\$1,000  
(Direct South Offset to SDX Lse S-22592)

1956 ELEVATION REPORT (TWH6-DC6)

5/11 Test Bartlesville Sand appx 2300'  
To commence by May 12, 1956  
To complete by June 12, 1956.  
(See DHC Agreement)

5/21 Moved in & Rigged up. Reamed 80'  
surface hole to 12 1/4". Ran 80' pipe  
& cemented w/40 sax cmt. WOC.  
Comm. 5-23-56. (Jackman & Jackman)

5/22 Drlg. 500' shale & lime. "

5/23 Drlg. 1125' lime. "

5/24 Drlg. 1550' lime & shale. "

5/25 Drlg. 2014' sand. To core #1. "

5/26 TD 2029 1/2'. Core #1, 2014-2028',  
rec 1100' gas, 100' oil & mud in hole.  
Reamed from 2014-2029 1/2'. Circ. 45 mins  
Laid down drill pipe @ 2032.31.  
Set csg. @ 2013 1/2' w/60 sax.  
(Jackman & Jackman)

5/29 8" @ 40'  
DST 2010-30, open 1/2 hr rec 100' oil.  
1100#. 4" @ ?  
BL. 985'. L. 1090', KC 1330',  
Bart 2012'. (F.R. Tkt)

6/13 Received copy of Halliburton Oil Well  
Cementing Co. "Formation testing Service  
Report. Given to S.A. Shannon, Div.  
Geologist.

1956  
6/20

Comm. 5-23-56 BL 985', L. 1090'  
8" @ 40 KC 1330' Bart. 2012'  
DST 2010-30 open  $\frac{1}{2}$  hr. rec 100' oil  
1100#. ~~1200#~~ TD 2031'.  $4\frac{1}{2}$ " @ 2012'  
PB 2017' FU 500' oil 24 hrs. Frac  
 $\frac{4}{8}$ . S/load. S/50 BO no wtr.  
Tested. P/20 BOPD + trace water.  
TD 2031' (Scout Comp. Tkt)

**COMPLETED**

7/23

Advised Contract Section - Oil Well



# CORRECTION

FORM 513 SUNRAY

County Greenwood Elev. \_\_\_\_\_  
 Sec. 19 Imp. 22 Rge. 11E  
 Name Pat Murphy  
 Address Harris No. 1

TOPS	DEPTH	LOG	DATUM	Loc. in Sec.
Anh.				<div style="border: 1px solid black; border-radius: 50%; padding: 5px; display: inline-block;"> <del>0 NE SW</del>                      NG NW SW                 </div>
Tr.				
H.				
Tr.				
Dg.	985			
Bl.				
L.	1090			
K.C.	1330			
B.K.C.				Geol. _____
Ce.				Contr. _____
C. <u>Bart.</u>	2012			<u>Jackman &amp;</u>
M.				<u>Pool Jackman</u>
M.				<u>DeMalorie-</u>
K.				<u>Sowder</u>
Me.				<div style="border: 1px solid black; padding: 5px; display: inline-block;">                     JUN 20 1956                      SDX-DHM                      ° X                 </div>
V.				<div style="border: 1px dashed black; padding: 5px; display: inline-block;">                         COMPLETE                     </div>
S.				
S.				
A.				
R.				
Pe.				
G.				
T.B.				

Date Comm. 5-23-56 Sunray MCPC - DHM  
8" @ 10 DST 2010-30 open 1/2 hr.  
rec. 100! oil 1100% 4" @ JUN 6 56 2012  
TD 2031 4 1/2" 2012  
PB 2017 FU 500' o. 1/24 hrs  
Frcl 4 1/8 sd \$ L  
\$ 50 BO N.W. Tst  
JUN 13 56 ~~ST~~ JUN 20 56 X P. 20 Bopd  
+ Trace wtu.