

KANSAS


Greenwood

Form 51-5M-2-29-34703

Map No. Sec. 19 Twp. 22 R. 11

Well No. 2 Harris Farm
Aladdin-Phillips Company

NORTH

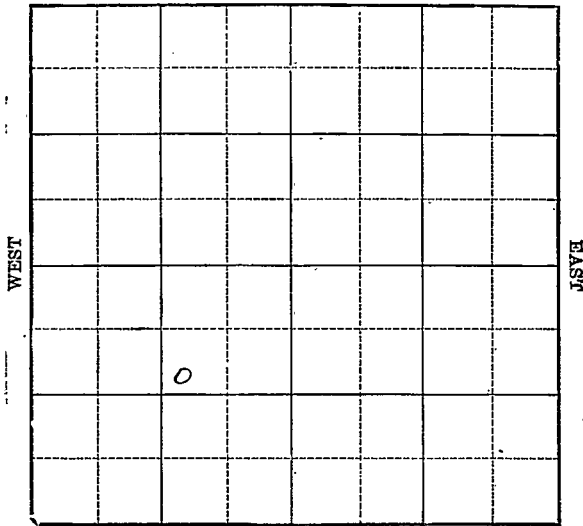

SOUTH

Location

Drilling Remarks

Rig Up

Drilling Remarks

RECORD

Cased in. ft.

Sand

Gas

Oil

Total Depth

PRODUCTION

1st 24 hrs. Nat.

1st 24 hrs. after shot

Gas cu. ft.

Dry Hole

Abandoned

Greenwood
 Map No. **KANSAS** Sec. *19* Twp. *22* R. *11*
 Well No. *2* = *Harris* Farm
Claddin & Phillips Company

NORTH

990 Ft. from N. Line

_____ Ft. from S. Line

990 Ft. from E. Line

1930 Ft. from W. Line

WEST

EAST

SOUTH

Date

REPORT

8/20

Spdy 200'

8/21

Blk 9. 950'

9/3

" 1440'

9/10

set 6"-2020

drlg in

9/17

Land 2043-67

TD 209.3

shot 180 gt

75 bbl oil

Comp.

Greenwood

21 KANSAS

Map No. _____ Sec. 19 Twp. 22 R. 11 E

Well No. 2 Harris

Aladdin & Phillips Company

Contractor

FIRST REPORTS

SECTION PLAT

990 Ft. from N. Line

_____ Ft. from S. Line

990 Ft. from E. Line

_____ Ft. from W. Line

	0		

Location _____

Rig up _____

Drilling and Remarks:

Apr 200'

RECORD

Cased _____ in., _____ ft.

Sand _____

Gas _____

Oil _____

Total Depth _____

PRODUCTION

1st 24 hrs. Nat. _____

1st 24 hrs. after shot _____

Gas _____ Cu. Ft.

Dry Hole _____

Abandoned _____

Date

AUG 20 1930

CHAS. L. SHERWOOD

19

Scout

Greenwood
 21 KANSAS Sec. 19 Twp. 22 R. 11
 Map No. 2 Harris
 Well No. Aladdin & Phillips Company
 Contractor

COMPLETE

SECTION PLAT

990 Ft. from N. Line

Ft. from S. Line

990 Ft. from E. Line

Ft. from W. Line

	o		

Location

Rig up

Drilling and Remarks:

180/75 bbs

RECORD

Cased in. ft.

Sand 7043-7067

Gas

Oil

Total Depth 7093

PRODUCTION

1st 24 hrs. Nat.

1st 24 hrs. after shot

Gas Cu. Ft.

Dry Hole

Abandoned

Date

SEP 17 1930

CHAS. L. SHERWOOD

19

Scout