

		O					

WEST EAST

SOUTH

[illegible]

Cased _____ in. _____ ft.
 Sand _____
 Gas _____
 Oil _____
 Total Depth _____

[illegible]


1st 24 hrs. Nat. _____
1st 24 hrs. after shot _____
Gas _____ cu. ft
Dry Hole _____
Abandoned _____

Map No. _____ Sec. 19 Twp. 22 R. 11Well No. ✓ Harris Farm _____Summons Company _____330 Ft. from N. Line

_____ Ft. from S. Line

990 Ft. from E. Line

_____ Ft. from W. Line

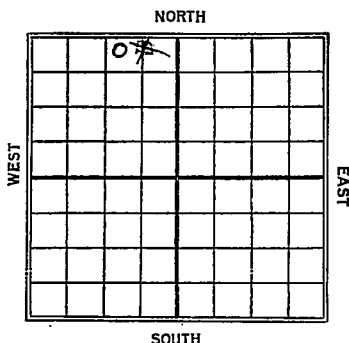

Date	REPORT
<u>1924</u>	
<u>2/1</u>	<u>Location</u>
<u>4/2</u>	<u>Lost hole 1400' Shidney</u>
<u>4/18</u>	<u>1700' 2nd hole</u>
<u>4/23</u>	<u>Top 2061. Log 2067</u>
	<u>no show.</u>
<u>5/1</u>	<u>2061-82- ID. 2099</u>
	<u>P.B to 2082'</u>
	<u>80/130 Bbls 1st 18 hrs,</u>
	<u>next 12 hrs idle</u>
	<u>2nd 12 hrs, Swab - 62 Bbls</u>
<u>5/22</u>	<u>Top 5 2041'-</u>
	<u>ID. 2099-</u>
	<u>80/ Swab 130 Bbls 1st 18</u>
	<u>hrs</u>

Map No. KANSAS 21 Sec. 19 Twp. 22 R. 11Well No. 2 HarrisImmense Company

Contractor

SPECIAL**SECTION PLAT**330 Ft. from N. Line
FIRST REPORT
Ft. from S. Line990 Ft. from E. Line

Ft. from W. Line

	●		

Location ✓ ✓

Rig up

Drilling and Remarks:

RECORD

Cased _____ in., _____ ft.

Sand _____

Gas _____

Oil _____

Total Depth _____

PRODUCTION

1st 24 hrs. Nat. _____

1st 24 hrs. after shot _____

Gas _____ Cu. Ft.

Dry Hole _____

Abandoned _____

Date

FEB 1924A. A. BENEAR

192

Scout

21 ~~4648~~ Map No. Sec. 19 Twp. 22 R. 11

Well No. 2 *Narrow*
Summons et al Company

Contractor

COMPLETED SECTION PLAT

258 Ft. from N. Line

_____ Ft. from S. Line

1070 Ft. from E. Line

_____ Ft. from W. Line

	0		

Location _____

Rig up _____

Drilling and Remarks:

Top of 204'

2099 F.D.

shot 70 ft. away

130 ft.

shot 18 hrs

RECORD

Cased _____ in., _____ ft.

Sand _____

Gas _____

Oil _____

Total Depth _____

PRODUCTION

1st 24 hrs. Nat. _____

1st 24 hrs. after shot _____

Gas _____ Cu. Ft.

Dry Hole _____

Abandoned _____

Date MAY 22 1924

M. A. BENEAR

192

Scout