


Map No. **KANSAS** Sec. **19** Twp. **22** R. **11**
 Well No. **3 Harris** Farm
Simmons Company

NORTH

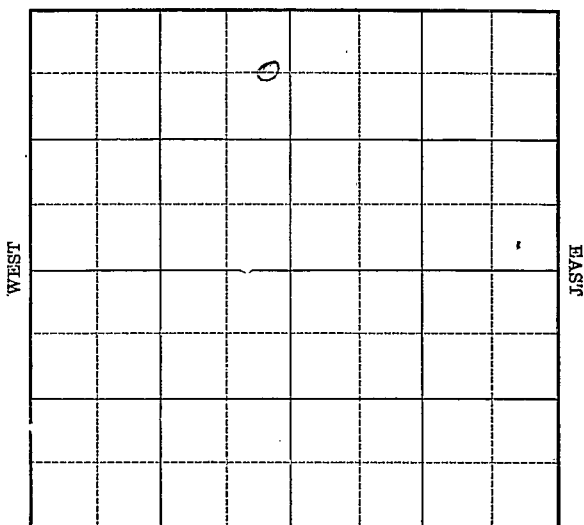

SOUTH

3

Location _____

Drilling Remarks _____

Rig Up _____

Drilling Remarks _____

RECORD

Cased _____ in. _____ ft.

Sand _____

Gas _____

Oil _____

Total Depth _____

PRODUCTION

1st 24 hrs. Nat. _____

1st 24 hrs. after shot _____

Gas _____ cu. ft.

Dry Hole _____


Abandoned _____

Map No. Kansas Sec. 19 Twp. 22 R. 11Well No. 3 Harris Farm
Simmons et al Company660 Ft. from N. Line

_____ Ft. from S. Line

330 Ft. from E. Line

_____ Ft. from W. Line

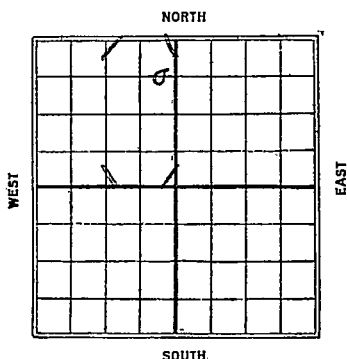

Date

REPORT



Sherwood Co

21 Map No. KANSAS Sec. 19 Twp. 22 R. 11
 Well No. 3 Harris
 Simmons et al Company

Contractor

SECTION PLAT

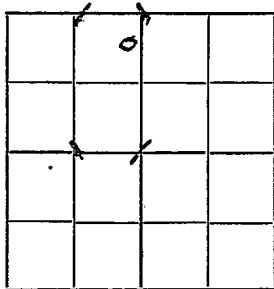

660 Ft. from N. Line

Ft. from S. Line

330 Ft. from E. Line

Ft. from W. Line

FIRST REPORTS

Location

Rig up & Tools.

Drilling and Remarks:

RECORD

Cased _____ in., _____ ft.

Sand _____

Gas _____

Oil _____

Total Depth _____

PRODUCTION

1st 24 hrs. Nat. _____

1st 24 hrs. after shot _____

Gas _____ Cu. Ft.

Dry Hole _____

Abandoned _____

Date

DEC 3 1 1925

192

CHAS. L. SHERWOOD

Scout

Sherwood Co

1621 KANSAS Sec. 19 Twp. 22 R. 11
 Map No. 3 Harris
 Well No. 3 Harris
 Simmons et al Company

Company

Contractor

COMPLETED

SECTION PLAT

	o		

660 Ft. from N. Line

Ft. from S. Line

330 Ft. from E. Line

Ft. from W. Line

ABANDONED

Location

Rig up

Drilling and Remarks:

Dry shale 2065-70'

Top line 2180'

Dry & ahead

2.1. 2205' 1st Break

RECORD

Cased _____ in., _____ ft.

Sand _____

Gas _____

Oil _____

Total Depth 2205'

PRODUCTION

1st 24 hrs. Nat. _____

1st 24 hrs. after shot _____

Gas _____ Cu. Ft.

Dry Hole ☒Abandoned ☒

Date

FEB 10 1926

CHAS. L. SHERWOOD

192

Scout