

Greenwood

Map No. *Kansas* Sec. *19* Twp. *22* R. *11*

Well No. *3 Harris* Farm


Selby Oil & Gas Company

_____ Ft. from N. Line

990 Ft. from S. Line

_____ Ft. from E. Line

990 Ft. from W. Line

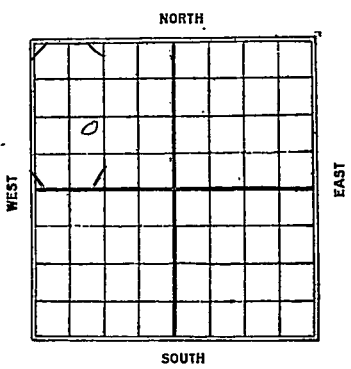

Date	REPORT
<i>1926</i>	
<i>3/25</i>	<i>Location</i>
<i>4/1</i>	_____
<i>4/7</i>	_____
<i>4/14</i>	_____
<i>4/21</i>	<i>Rig</i>
<i>4/30</i>	<i>Rigs</i>
<i>5/8</i>	<i>Dlg 1150</i>
<i>5/12</i>	<i>" 1650'</i>
<i>5/19</i>	<i>J.D. 2200 Missed Sand</i>
	<i>MA 2200'</i>

Shenwood

K21
Map No. **KANSAS** Sec. *19* Twp. *22* R. *11*

Well No. *3 Harris*
Selby Oil Co Company

Contractor

FIRST REPORTS

SECTION PLAT

_____ Ft. from N. Line

990 Ft. from S. Line

_____ Ft. from E. Line

990 Ft. from W. Line

○			

Location _____

Rig up _____

Drilling and Remarks:

RECORD

Cased _____ in., _____ ft.

Sand _____

Gas _____

Oil _____

Total Depth _____

PRODUCTION

1st 24 hrs. Nat. _____

1st 24 hrs. after shot _____

Gas _____ Cu. Ft.

Dry Hole _____

Abandoned _____

Date

MAR 25 1926

CHAS. L. SHERWOOD

192

Scout

Greenwood

K21
Map No. KANSAS Sec. 19 Twp. 22 R. 11

Well No. 3 *Harris*

Leiby Oil & Co Company

Contractor

COMPLETED

SECTION PLAT

----- Ft. from N. Line

990 Ft. from S. Line

----- Ft. from E. Line

990 Ft. from W. Line

o			

ABANDONED

Location -----

Rig up -----

Drilling and Remarks

missed sand

DEG

2200'

RECORD

Cased ----- in., ----- ft.

Sand -----

Gas -----

Oil -----

Total Depth *2200'*

PRODUCTION

1st 24 hrs. Nat. -----

1st 24 hrs. after shot -----

Gas ----- Cu. Ft.

Dry Hole

Abandoned

Date

MAY 19 1926

192

CHAS. L. SHERWOOD

Scout